


T.41 S.R.13 W.W.M.

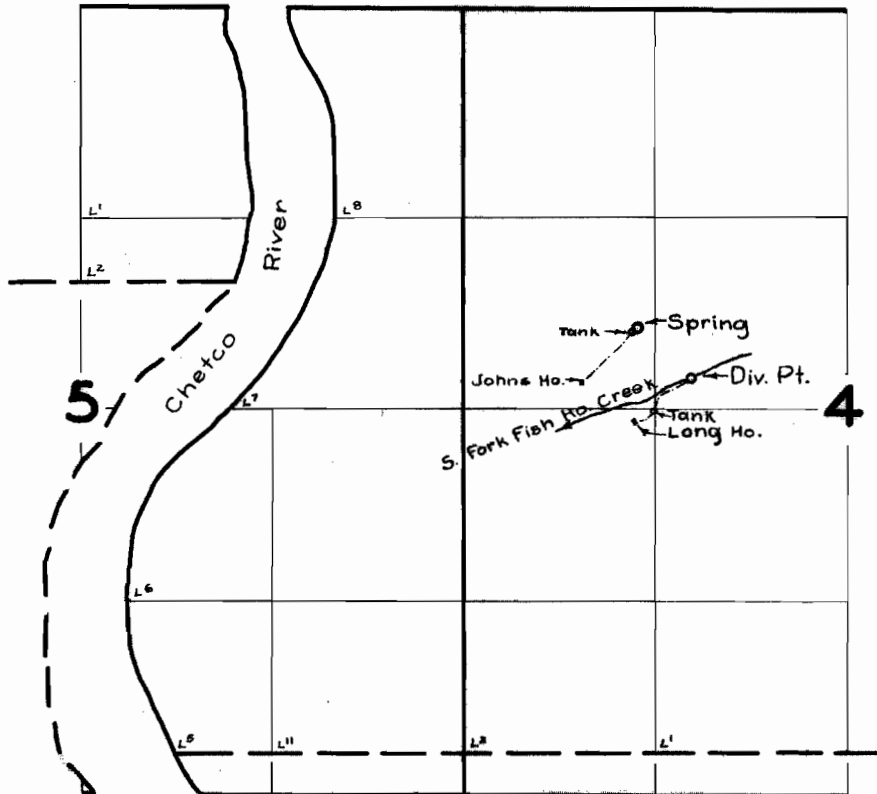

FINAL PROOF SURVEY UNDER

Application No. 22641 Permit No. 17797
IN NAME OF

Henry L. & Adeline Kerr

Surveyed Mar. 19 1958, by M. B. Bish