


T.5S. R.1W.W.M.

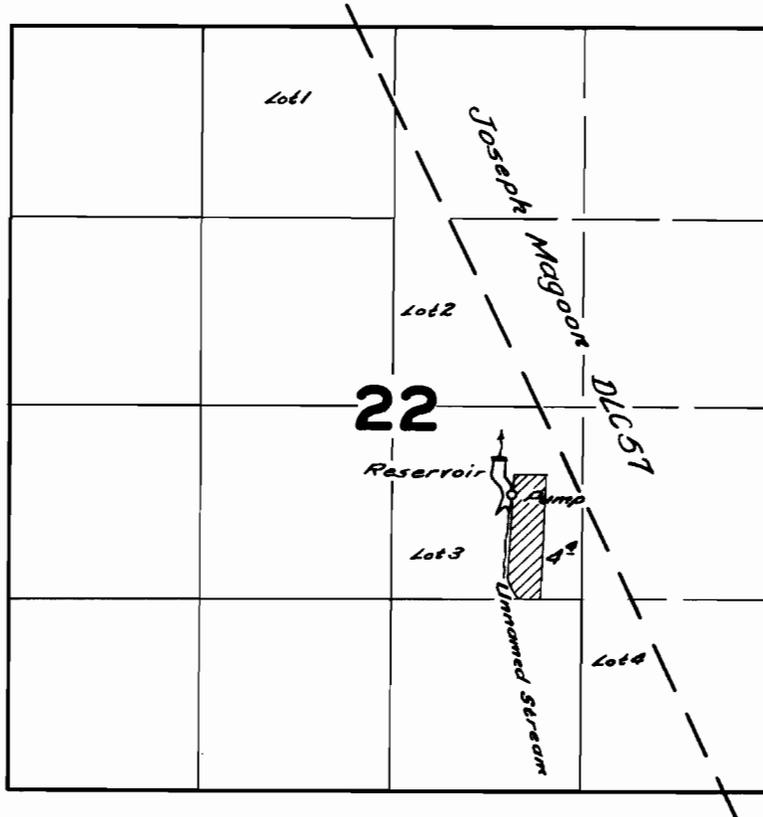

FINAL PROOF SURVEY UNDER

Application No. ^{P-29371} 29372. Permit No. ^{P-1665} 23143.
IN NAME OF

Alvin McLaughlin

Surveyed April 24 1958, by *C. M. Burt*