


T.5S. R.1W.W.M.

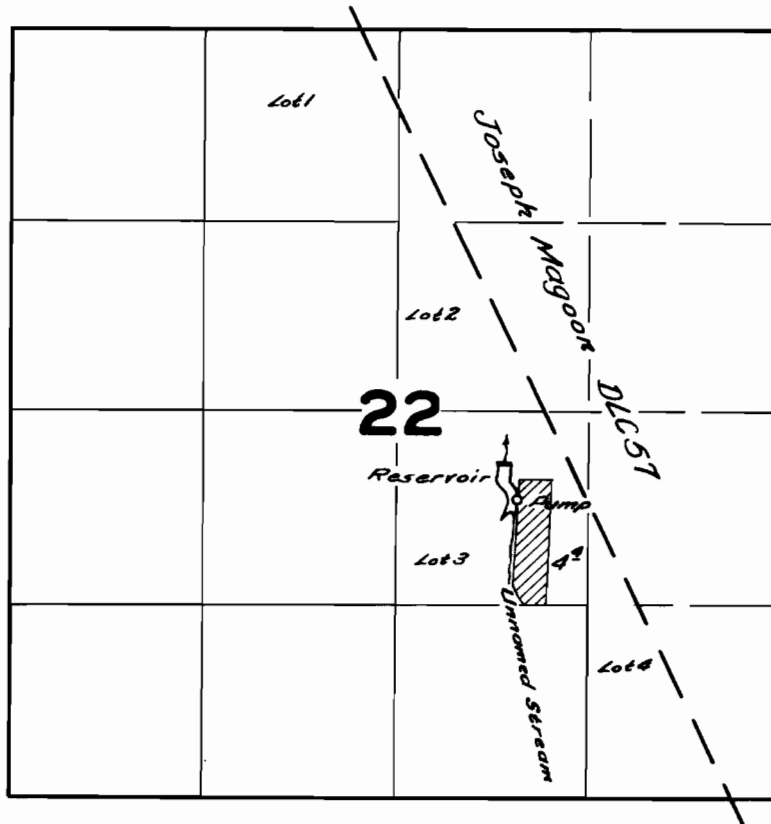

FINAL PROOF SURVEY UNDER

Application No. ^{R-29371} 29372. Permit No. ^{R-1665} 23143.
IN NAME OF

Alvin McLaughlin

Surveyed *April 24* 1958, by *C. M. Burt*