


T.7S. R.4 W.W.M.

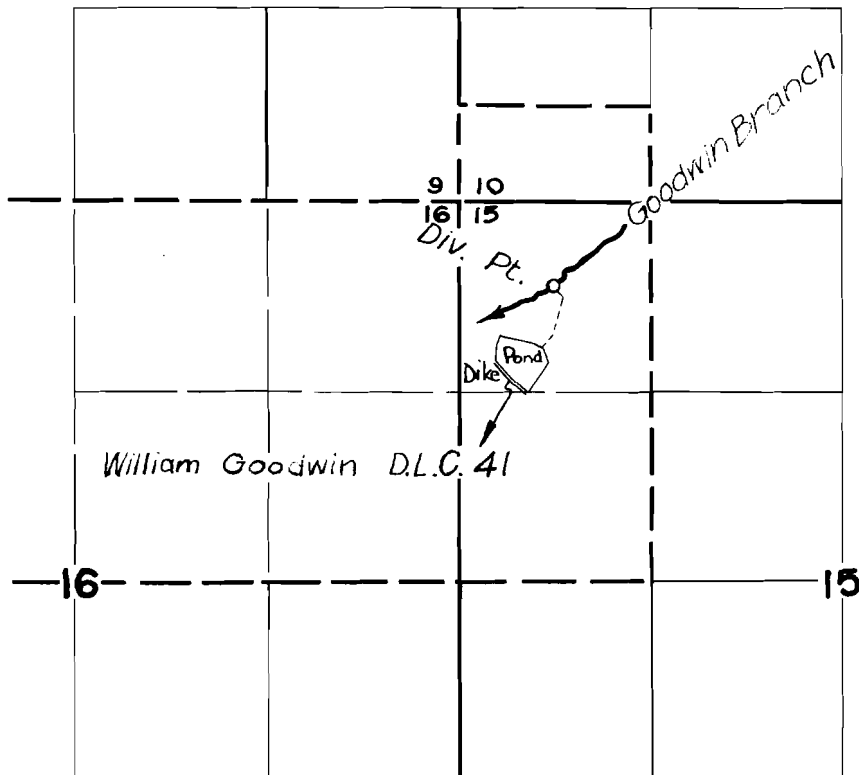

FINAL PROOF SURVEY
UNDER

Application No. ^{R-31907} 31908 Permit No. ^{R-2083} 25160
IN NAME OF

WILLIAM E. DOMES

Surveyed March 31, 1958, by R.H. Whitby