


T. 39S, R. 1E, W.M.

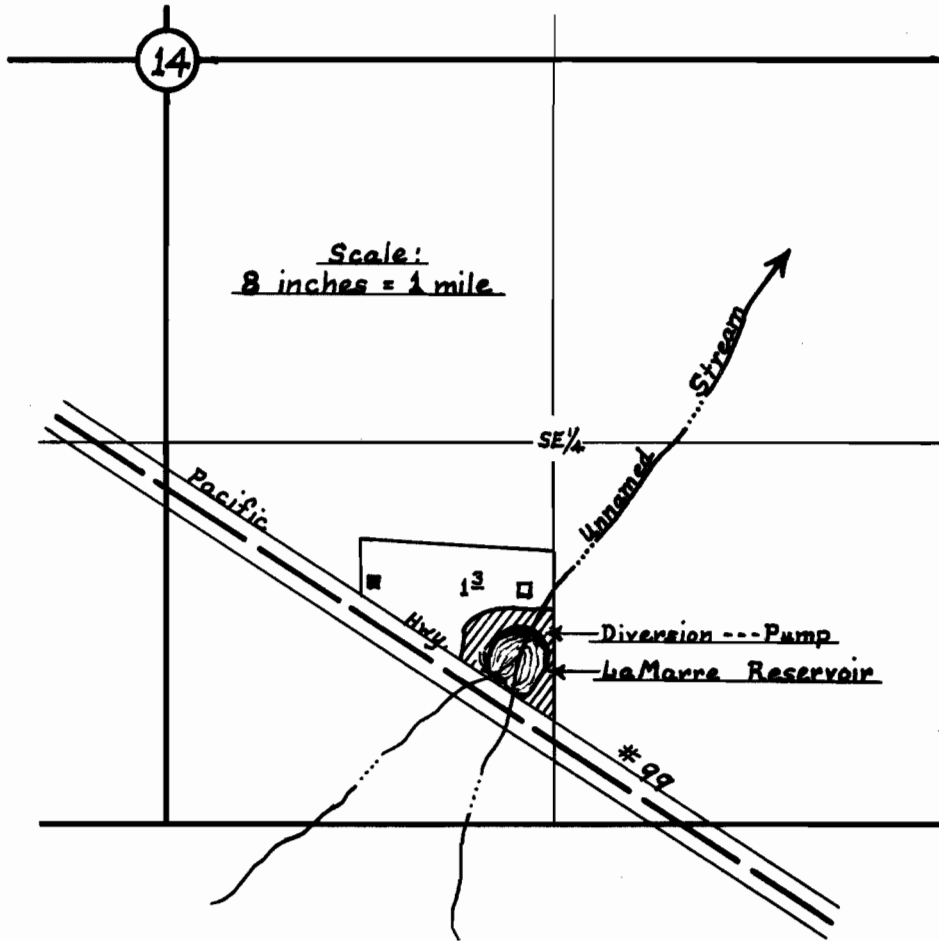

FINAL PROOF SURVEY

UNDER

R-31636 R-2029
Application No. 31637 Permit No. 24937

IN NAME OF

E. J. LaMarre

Surveyed 2-23, 1959, by D.C. Hendrix, W.M.