


T.6S. R.5W.W.M.

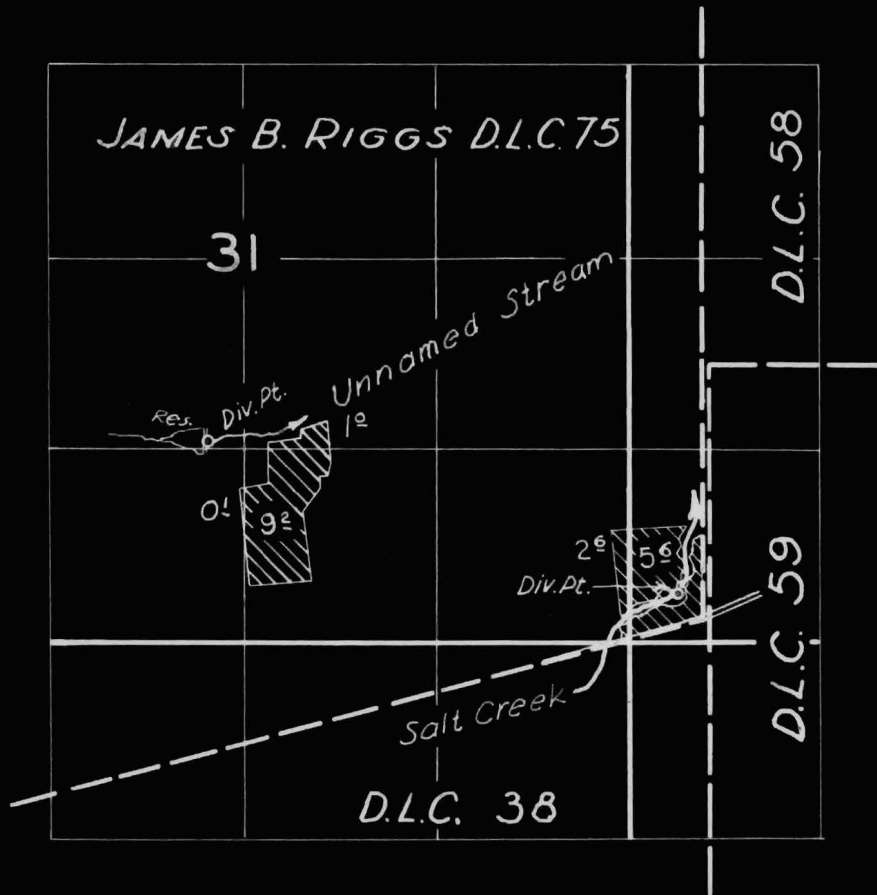

FINAL PROOF SURVEY
UNDER

R-30350 R-1821
Application No. 30351 Permit No. 23972
IN NAME OF

SILAS E. STARR

Surveyed April 9 1958, by R.H. Whitby