


T. 1 N. R. 2 W. W.M.

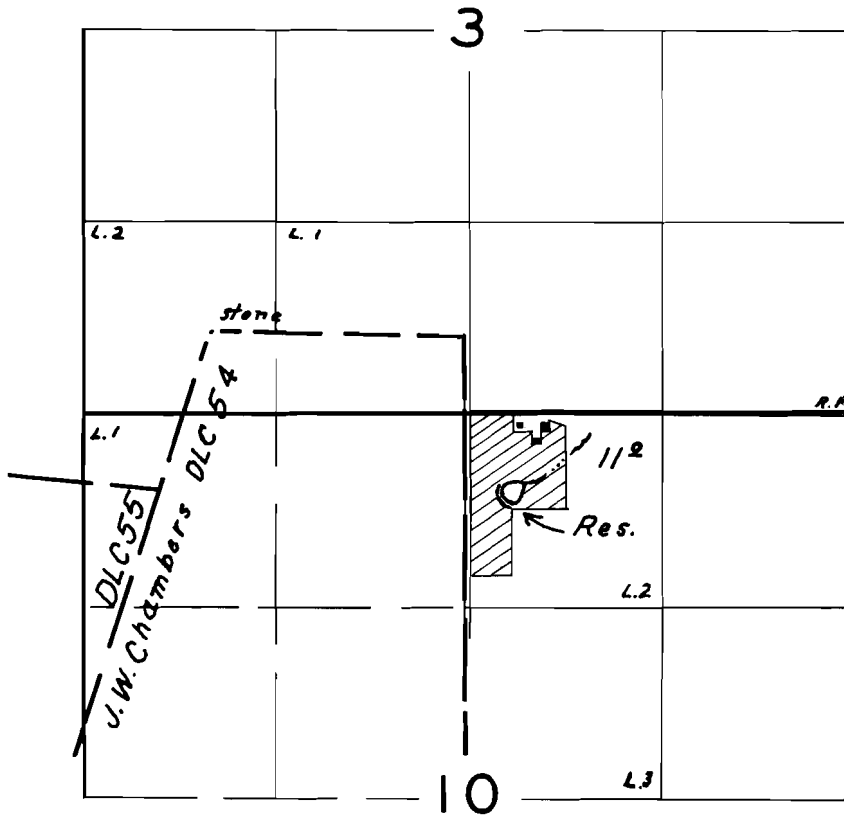

FINAL PROOF SURVEY
UNDER

R-29681 *R-1708*
Application No. *29682* Permit No. *23373*
IN NAME OF

Elmer J. Gossen

Surveyed *May 2* 1958, by *R.H. Whitby*