


# T.6S. R.1E.W.M.

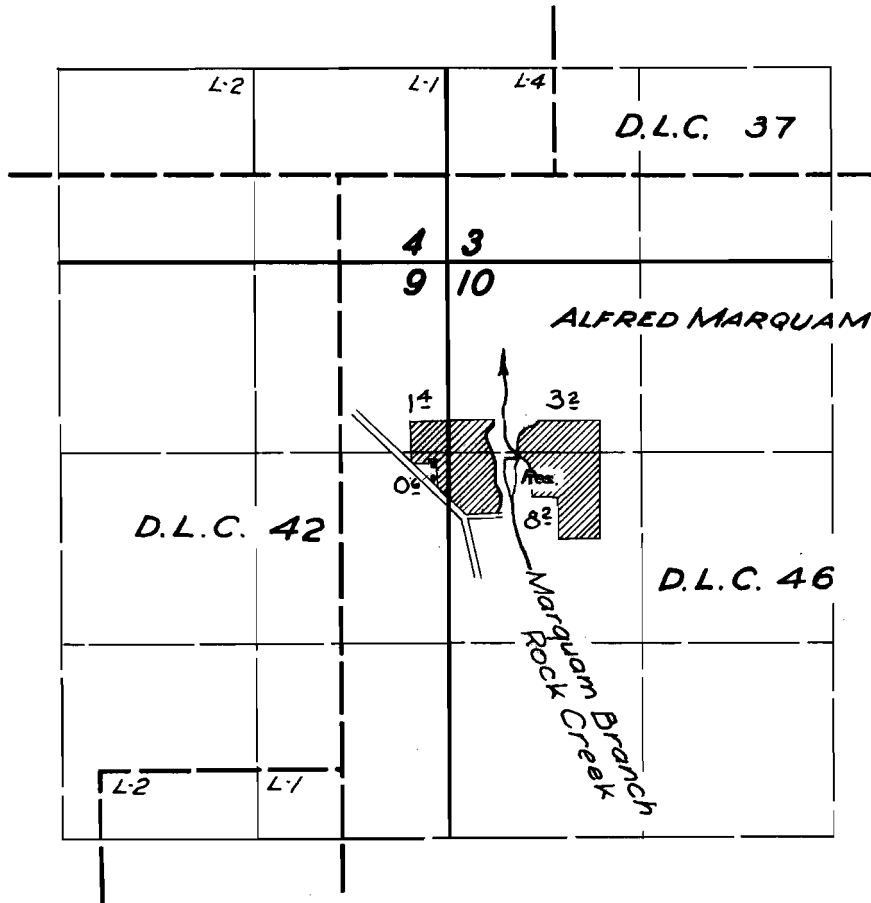

## FINAL PROOF SURVEY UNDER

R-29416 R-1670  
Application No. 29417 Permit No. 23165  
IN NAME OF

O. A. MARQUAM & SON

Surveyed 20 June 1958, by C.O. Bartels