


T. 1N. R. 3W. W.M.

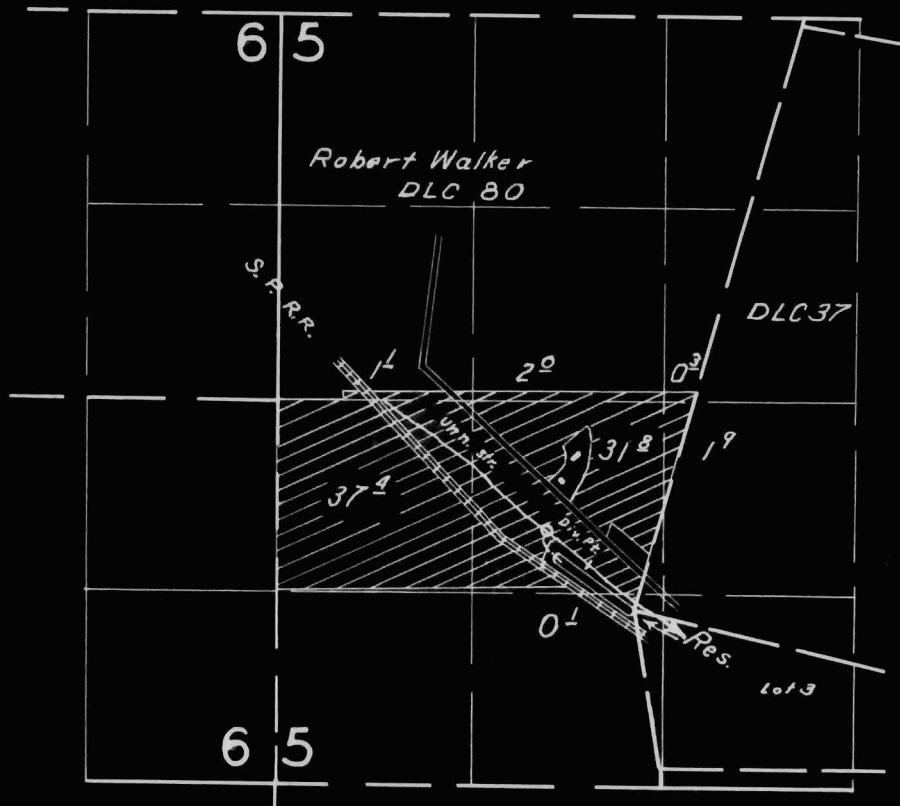

FINAL PROOF SURVEY
UNDER

Application No. *R-30150* / *30151* Permit No. *R-1786* / *23789*
IN NAME OF

Raymond H. & Eleanor V. Van Domelen

Surveyed *April 29 1958*, by *R. H. Whitby*