


T.7S. R.5 W.W.M.

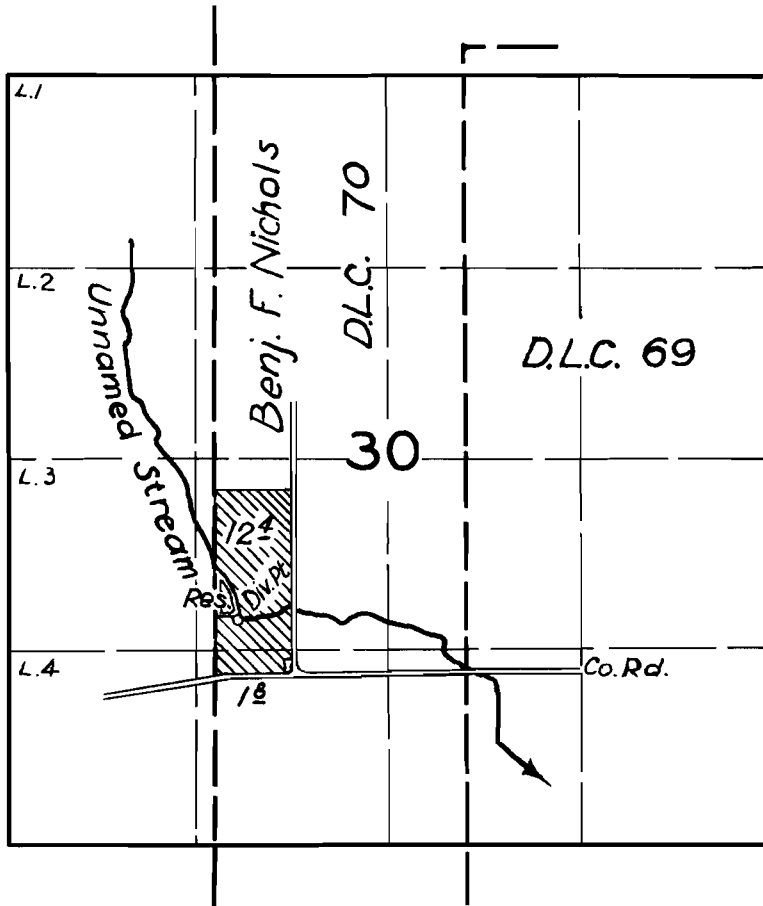

FINAL PROOF SURVEY
UNDER

Application No. ^{R-31026} 31027... Permit No. ^{R-1743} 23561...
IN NAME OF

FORREST MARTIN

Surveyed April 2, 1958, by R.H. Whitby