


Map of Antelope pipe line
I A W Mohr hereby certify that this map was made from notes taken during an actual survey made by me June 1 1918 and that it correctly represents the facts in the accompanying application together with the streams and other ditches in the immediate vicinity

A W Mohr
Surveyor.

T75 R17E

1276 fLS 8 1496 f1 W of N E
1255 fE west 125 ft South of the N.E. Cor
Spring 3 Sec 31 T75 R17E.

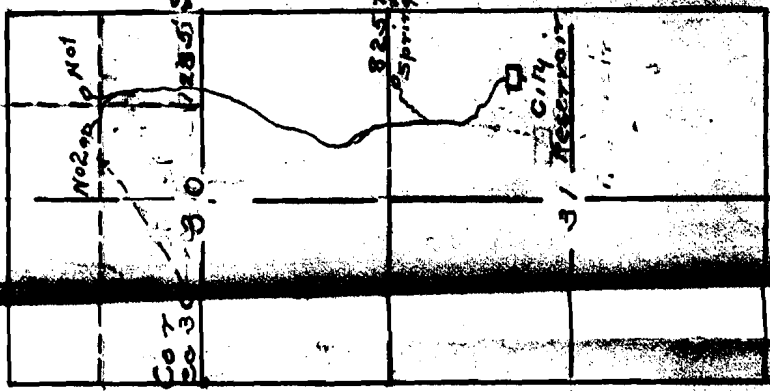

FEB 1919

Application No 6
Permit No 40
4027