


T.5S. R.3E.W.M.

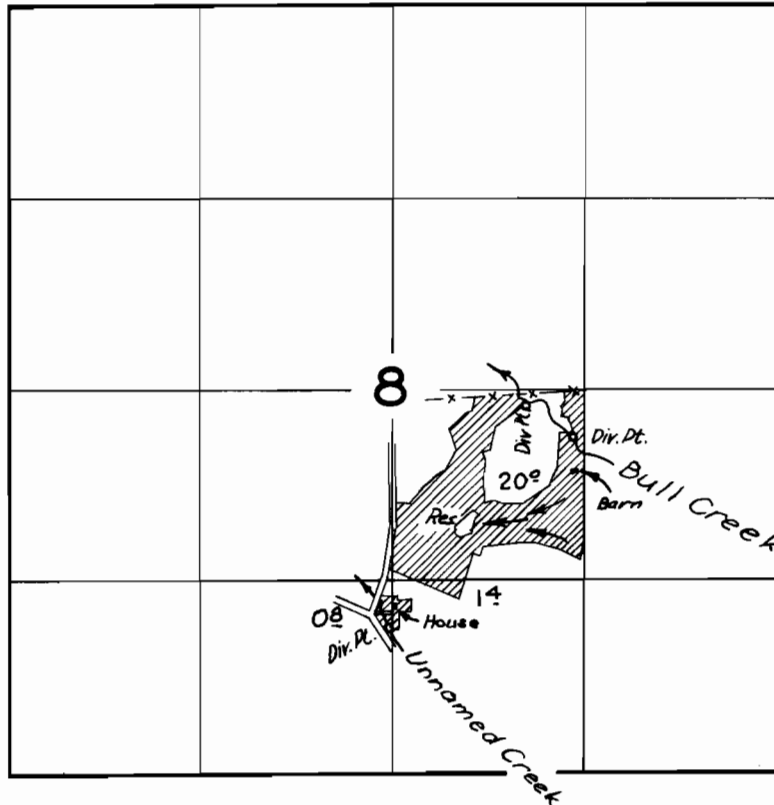

FINAL PROOF SURVEY
UNDER

R-28517 R-1496
Application No. 28461 Permit No. 22291
IN NAME OF

FRED E. WALLACE

Surveyed 19 June 1958, by C.O. Bartels