


T.41 S.R.13 W.W.M.

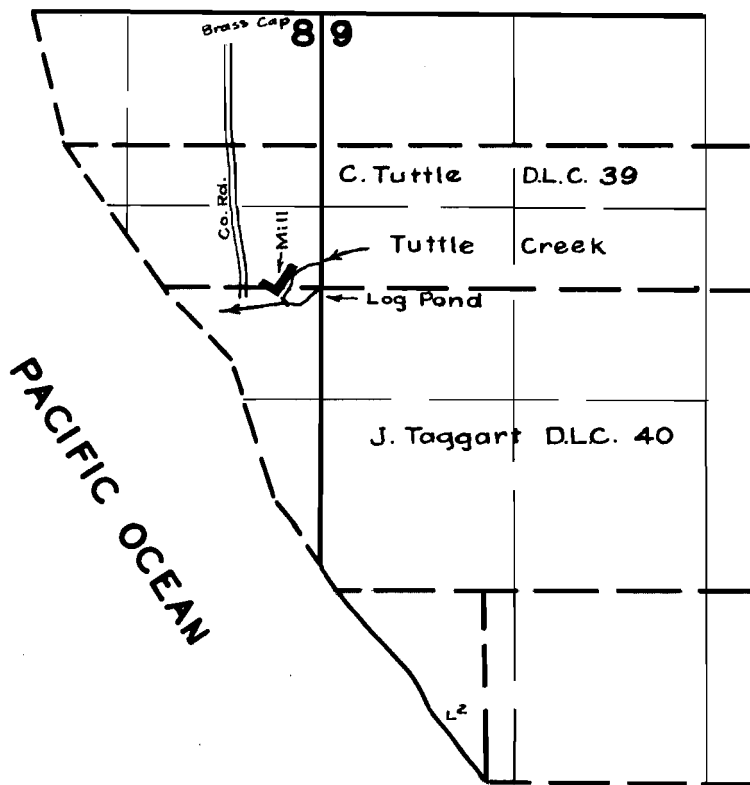

FINAL PROOF SURVEY UNDER

Application No. R-26763 26764 Permit No. R-1320 21030
IN NAME OF

Thompson Bros. Lbr. Co.

Surveyed Mar. 18 1958, by Tr. Bick