


20381

T.1S. R.12E.W.M.

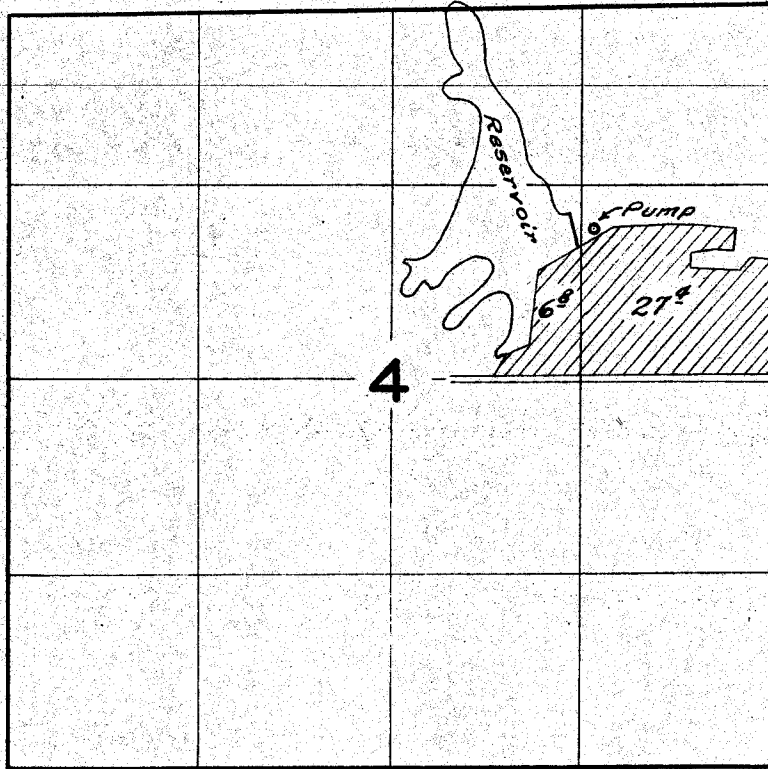

FINAL PROOF SURVEY UNDER

Application No. *R-25806* 26025. Permit No. *R-1160* 20381
IN NAME OF

Worth Evans

Surveyed *June 6* 1958, by *C.C. Bartels*