


18342

T.2N. R.10E. W.1A.

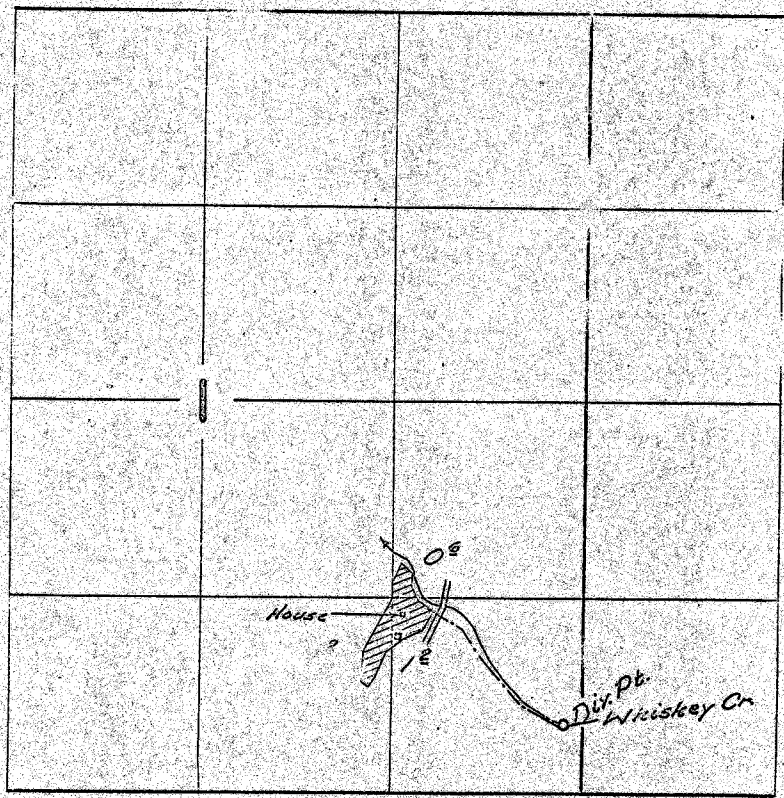

FINAL PROOF SURVEY
UNDER

Application No. 23219 Permit No. 18346
IN NAME OF

Karl F. G. Schmidt

Surveyed June 3, 1958, by Ed. Bartel