


T.8S. R.5 & 6 W.W.M.

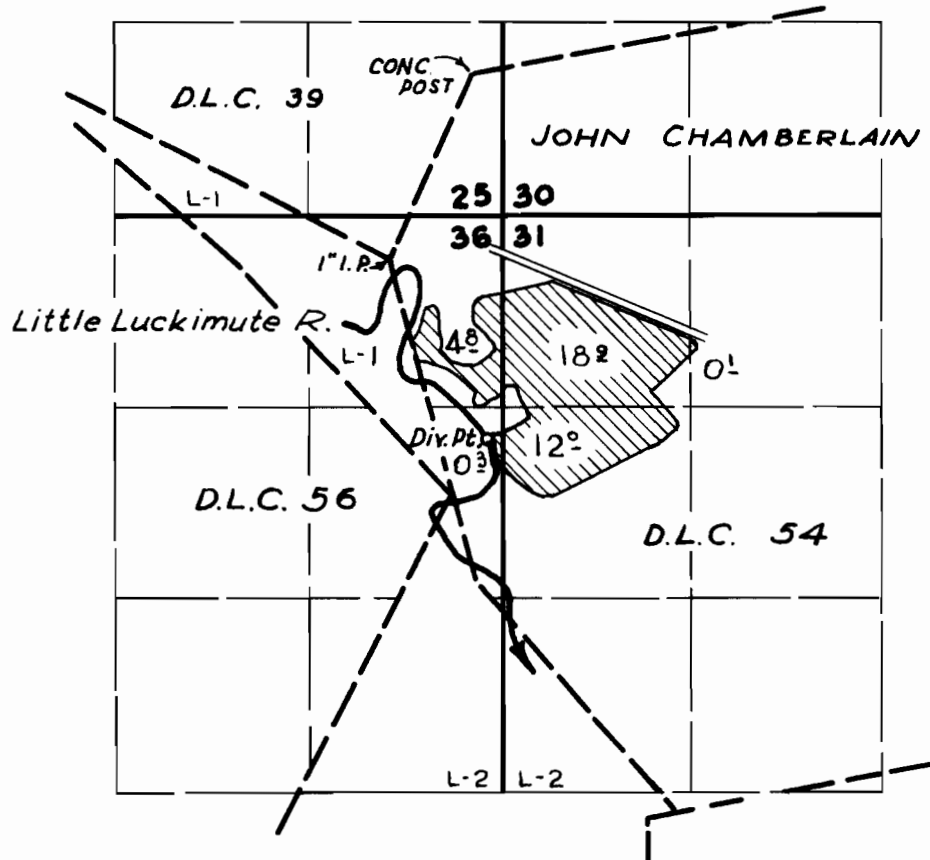

FINAL PROOF SURVEY
UNDER

Application No. 24778. Permit No. 19668
IN NAME OF

E. S. DIXON

Surveyed April 23 1958, by R.H. Whitby.