


T. IN. R. 3W. W.M.

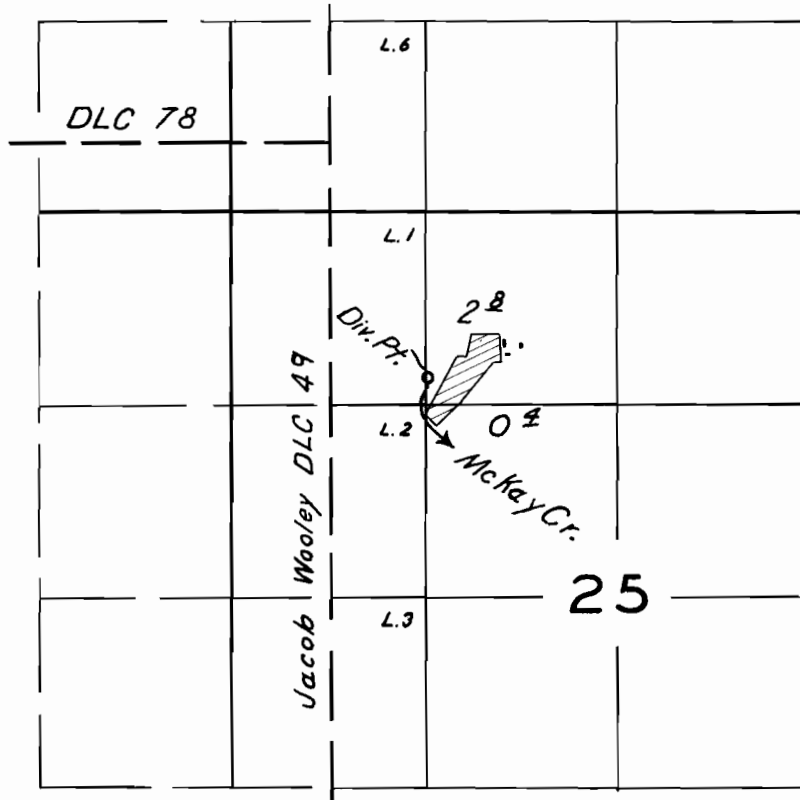

FINAL PROOF SURVEY
UNDER

Application No. 26311 ... Permit No. 20465
IN NAME OF

E.K. Prickett

Surveyed April 29 1958, by *R.H. Whitby*