


# T.14 S. R.1 W.W.M.

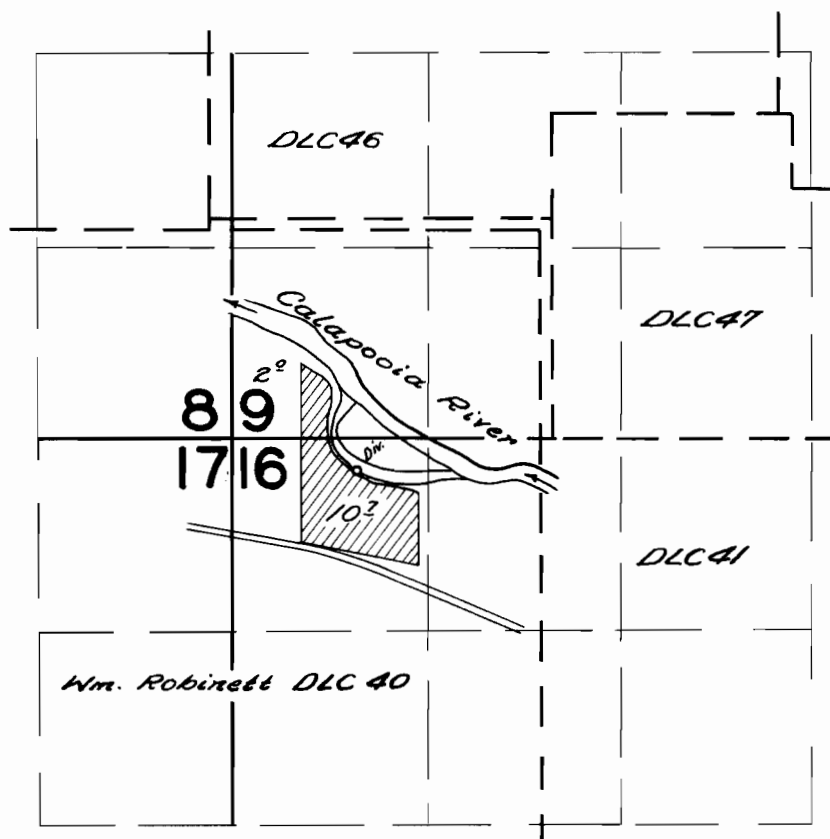

## FINAL PROOF SURVEY UNDER

Application No. 26404 Permit No. 20714  
IN NAME OF

*R. R. Robirett*

Surveyed *Sept. 8*, 1958, by *C. O. Sautels*