


T.4 S.R.4 W.W.M.

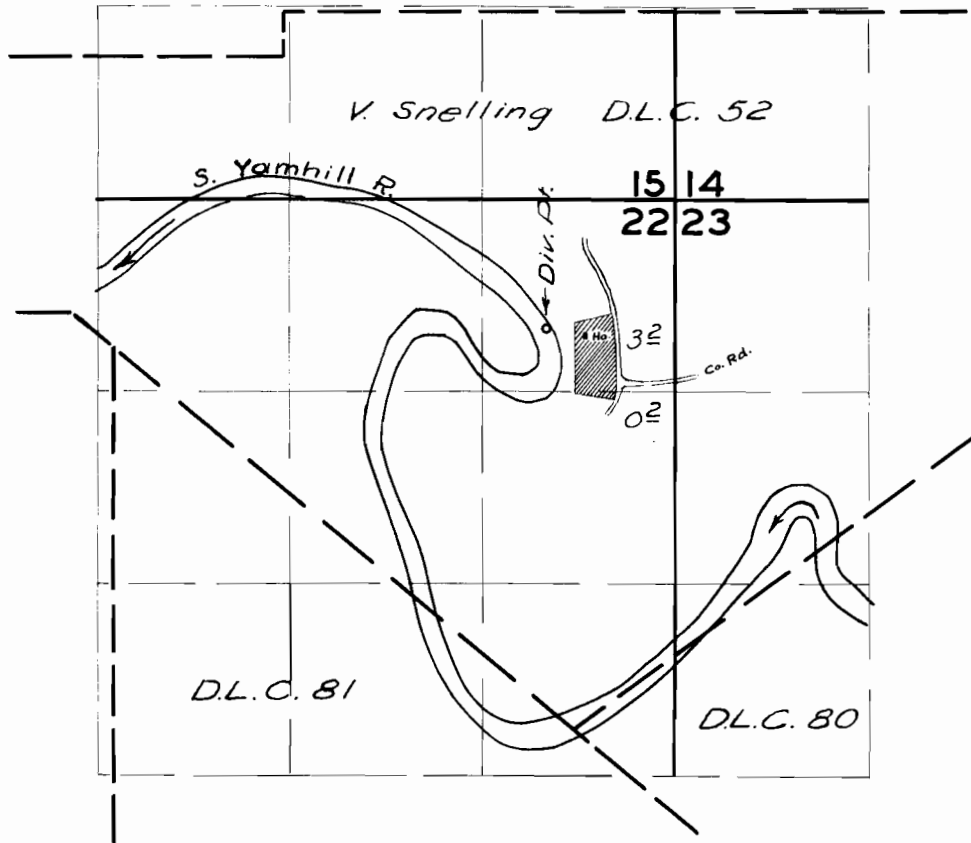

FINAL PROOF SURVEY UNDER

Application No. 26588 Permit No. 20828
IN NAME OF

A.G. SULAK

Surveyed 30 April 1958, by *M. Bish*