


T.18 S. R. 3W. W.M.

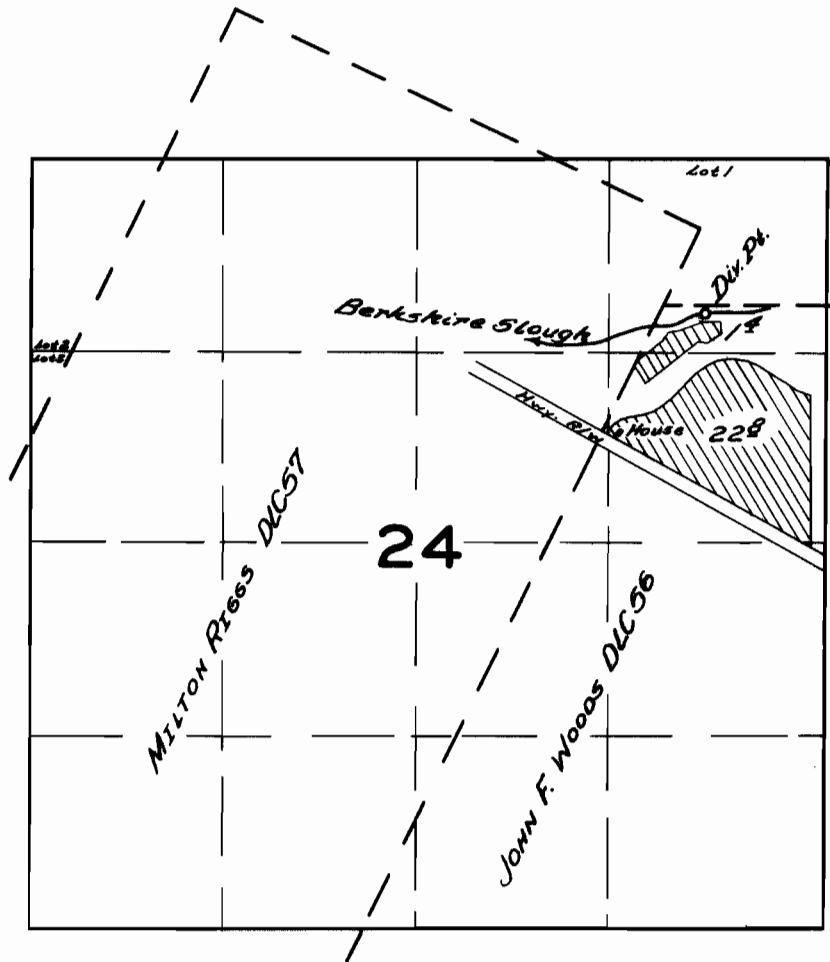

**FINAL PROOF SURVEY**  
UNDER

Application No. *26884*... Permit No. *21107*...  
IN NAME OF

.....*Harold K. McPherson*.....

Surveyed *May 2*... 19*57*.. by *M. Bisk*.....