


T.12S. R.6 W.W.M.

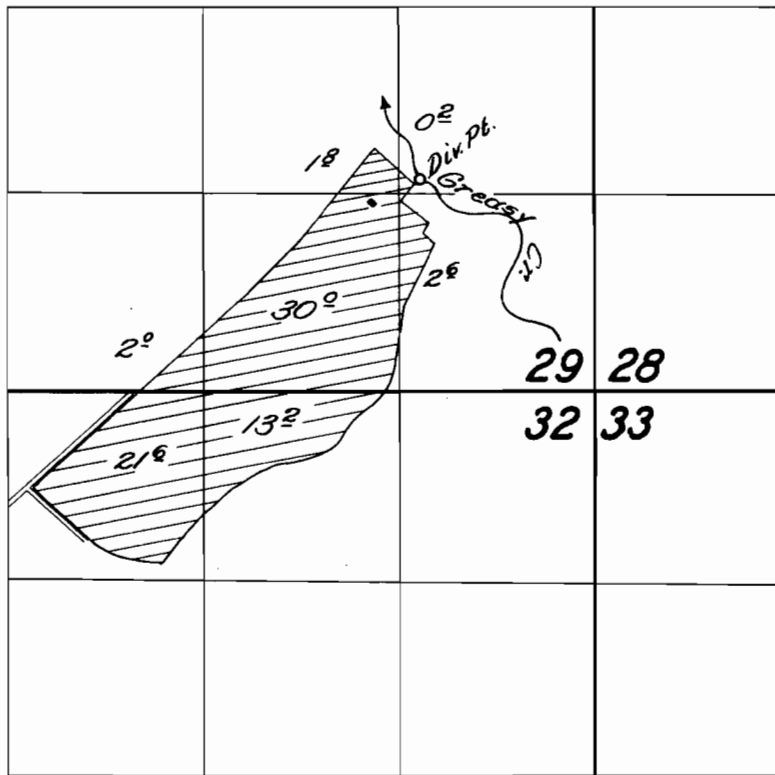

**FINAL PROOF SURVEY**  
UNDER

Application No. *26911* Permit No. *21146*  
IN NAME OF

*Ben Gooch*

Surveyed *Sept. 18* 1958, by *M. Biste*