


# T.4 | S.R.13W.W.M.

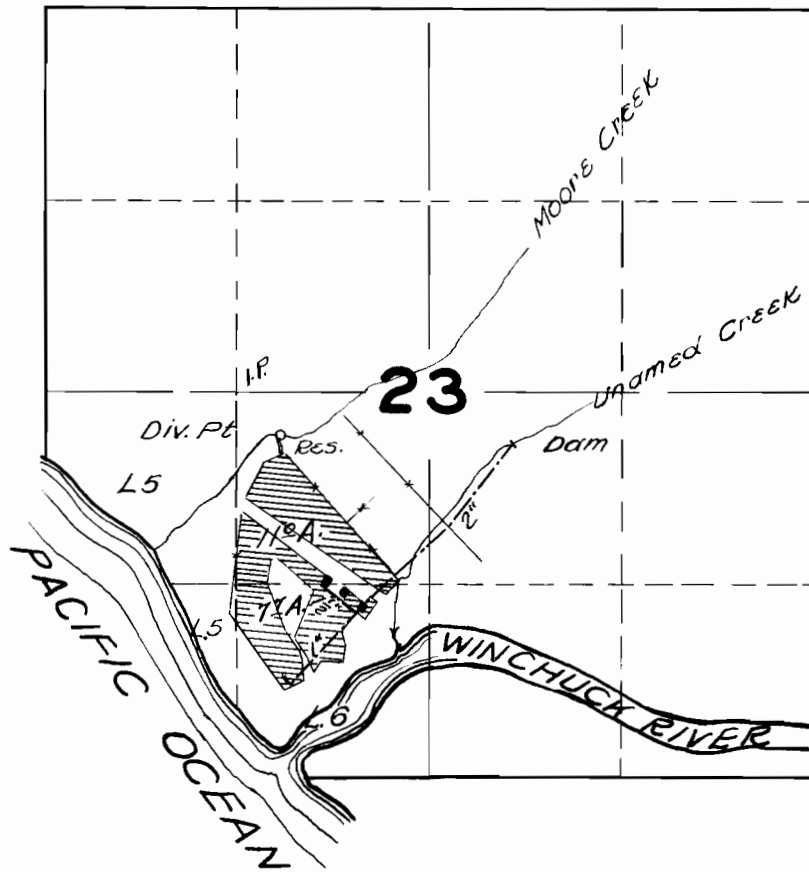

## FINAL PROOF SURVEY

UNDER

*R. 16941*

*R. 706*

Application No. *16942* Permit No. *12648*

IN NAME OF

*ENOS A. & RENAK POTTS*

Surveyed AUG. 11. 1949., by H.L. COFFMAN.