


T.17 S.R.2 W.W.M.

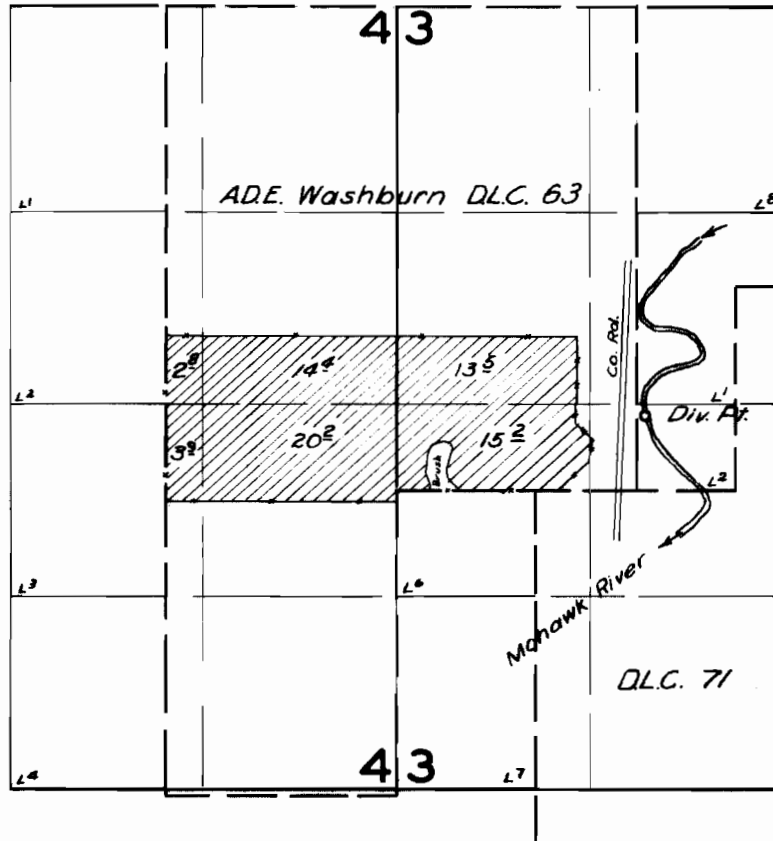

FINAL PROOF SURVEY

UNDER

Application No. 26840 Permit No. 21664
IN NAME OF

Commerce J. & Mary E. Calkins

Surveyed May 7, 1957, by M. B. Bish