


T. 1N. R. 2W. W.M.

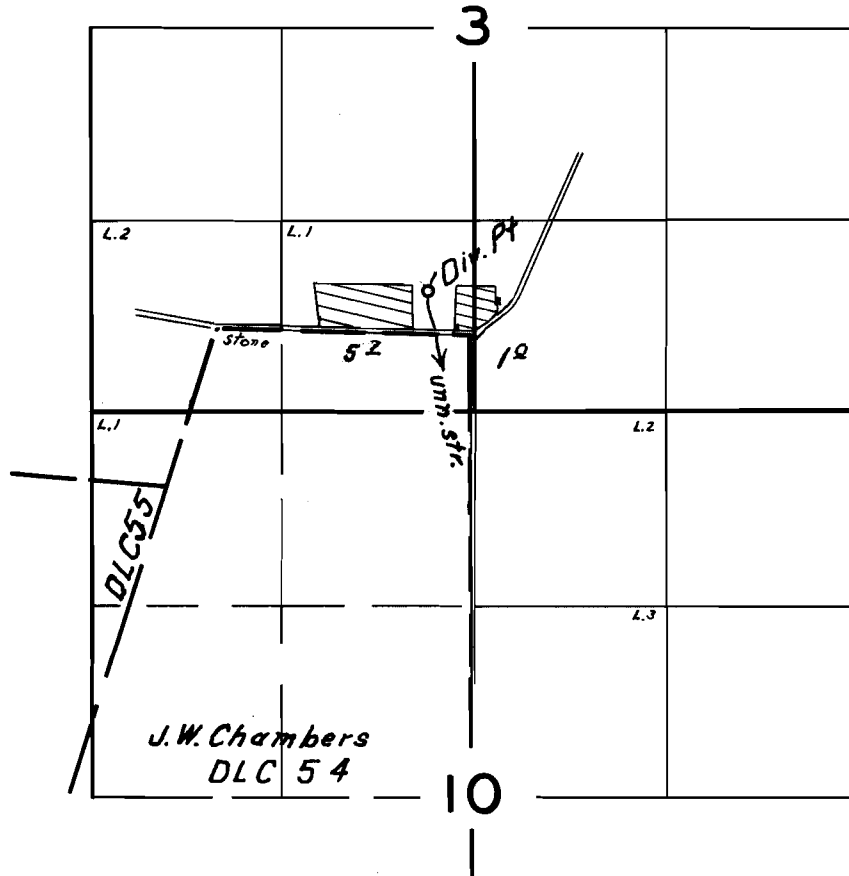

**FINAL PROOF SURVEY**  
UNDER

Application No. 27761 Permit No. 21858  
IN NAME OF

Helen L. Hofer

Surveyed May 2, 1958, by R. H. Whitby