


T. 1N. R. 2 & 3W. W.M.

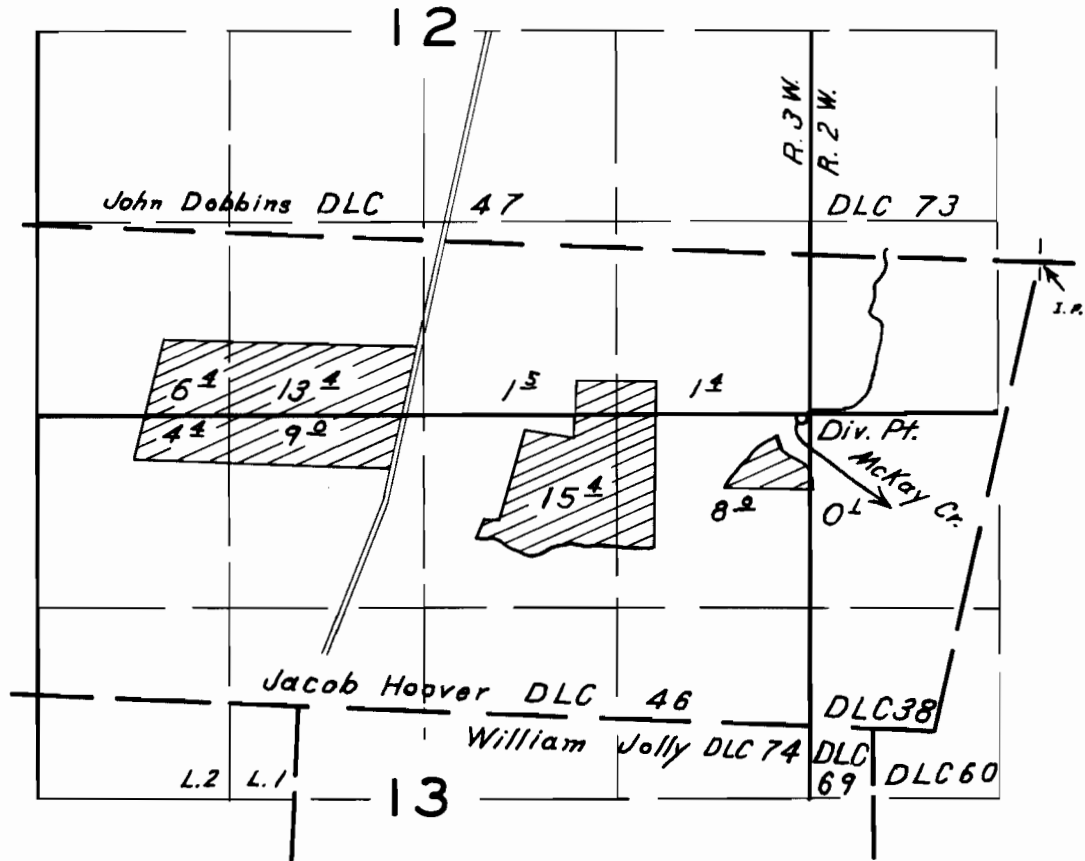

FINAL PROOF SURVEY
UNDER

Application No. 28095 Permit No. 22120
IN NAME OF

Remi Coussens

Surveyed April 29 1958, by R. H. Whitby