


T.4 | S.R.13 W.W.M.

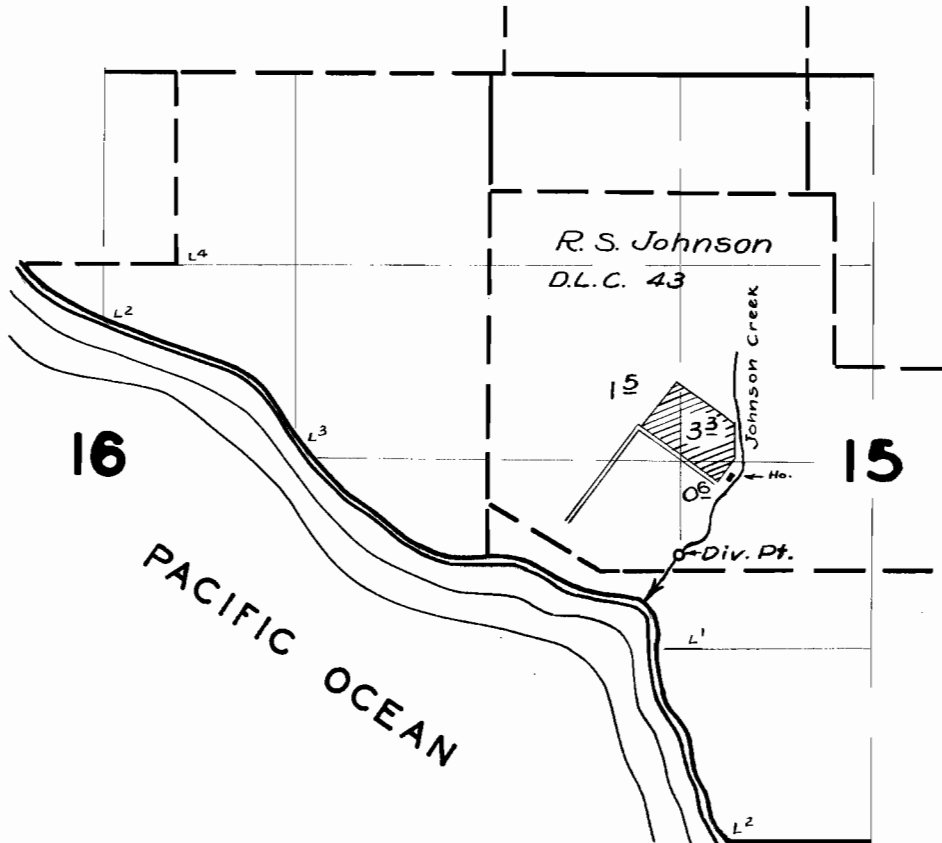

FINAL PROOF SURVEY
UNDER

Application No. 28416 Permit No. 22252
IN NAME OF

Roger I. & Doris A. Oliver

Surveyed Mar. 24 1958, by M. Bish