


T. 30 S. R. 6 W. W.M.

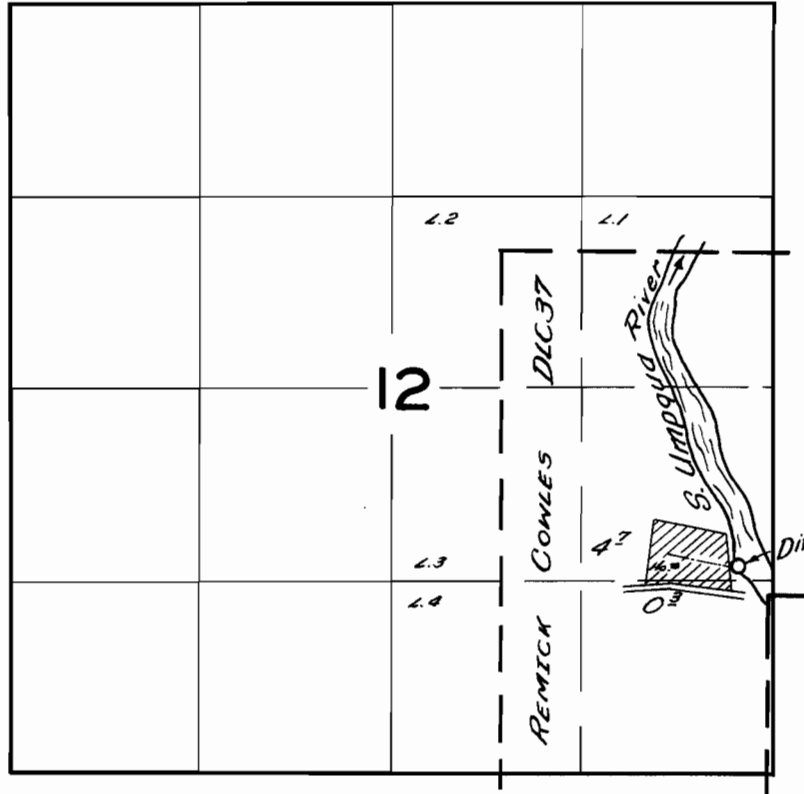

**FINAL PROOF SURVEY**  
UNDER

Application No. 28308... Permit No. 22257...  
IN NAME OF

*Ernest S. & Josephine I. Pruner*

Surveyed April 12, 1957, by C. O. Bartels