


T.5 S.R.7 W.W.M.

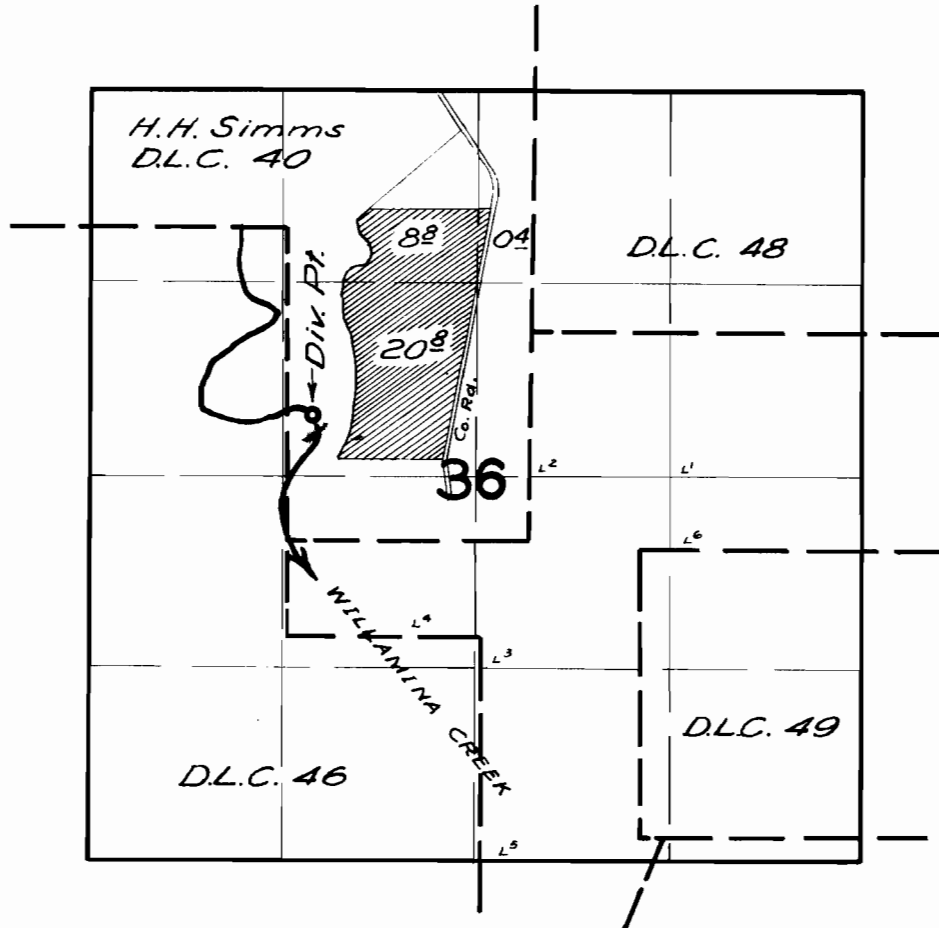

FINAL PROOF SURVEY
UNDER

Application No. 28460 Permit No. 22290
IN NAME OF

ANDREW H. KERSHAW

Surveyed 11 April 19.58, by *M. Gish*