


T.6S. R.7 W.W.M.

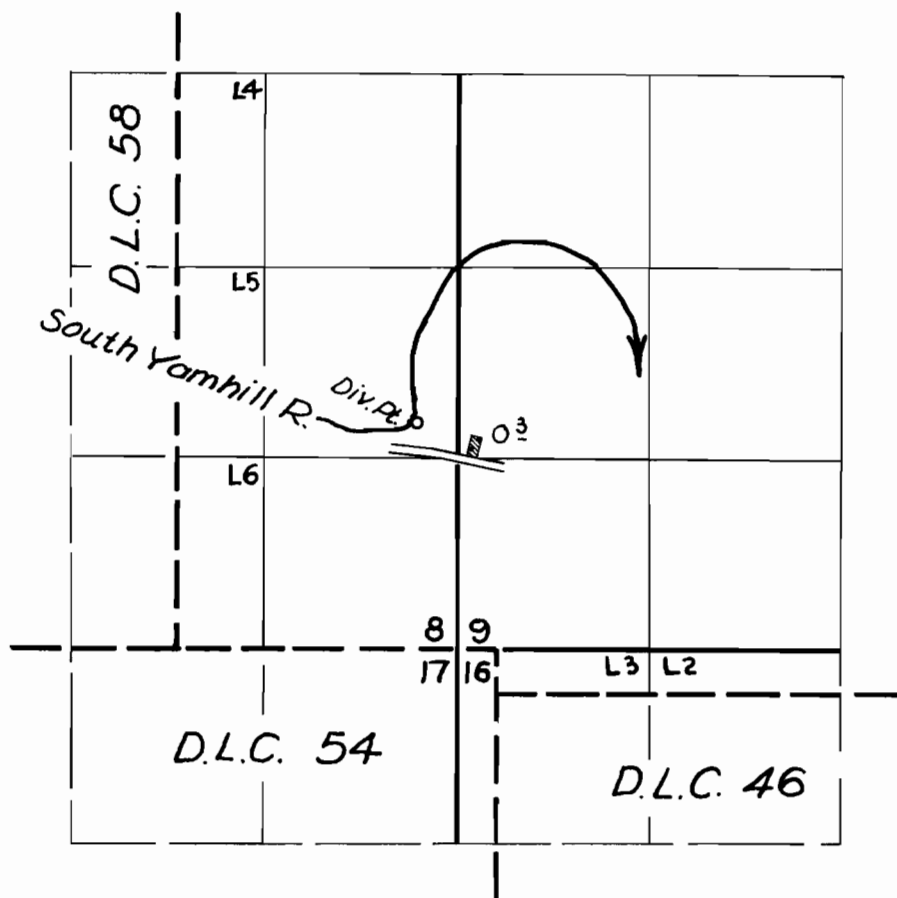

FINAL PROOF SURVEY
UNDER

Application No. 28390 . Permit No. 22396
IN NAME OF

MELVIN SUMPTER

Surveyed July 30 1957, by R.H. Whitby