


T.6S. R.7 W.W.M.

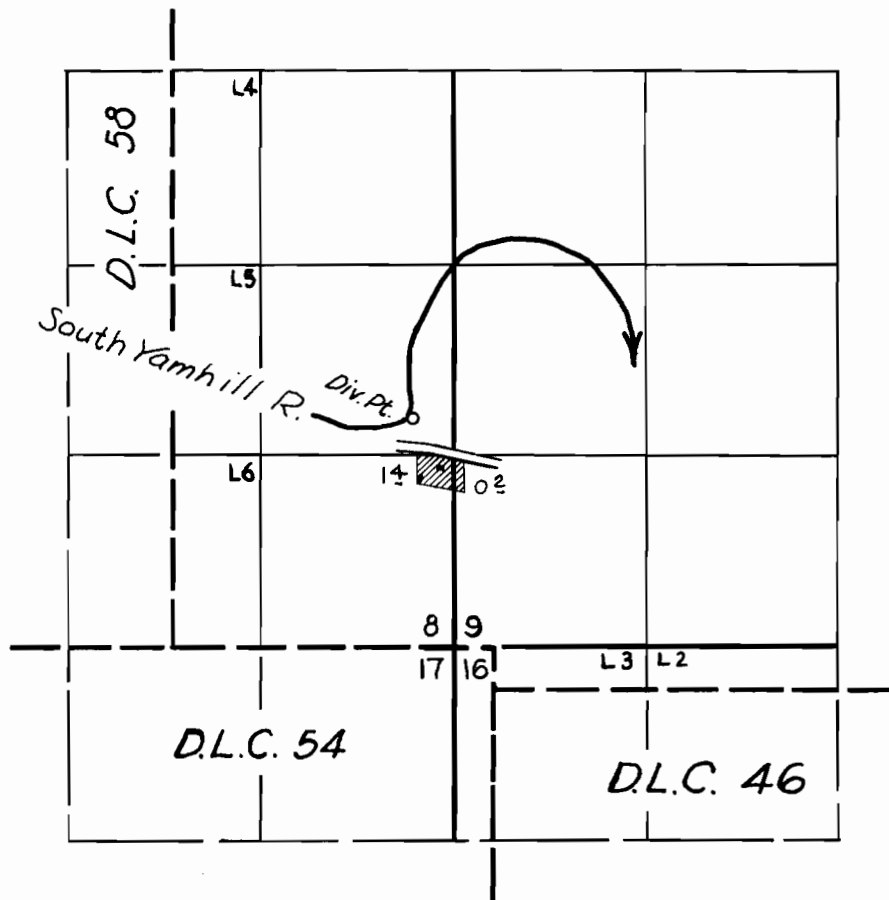

**FINAL PROOF SURVEY**  
UNDER

Application No. 28391... Permit No. 22397  
IN NAME OF

**LEWIS FRANKLIN GALLIGHER**

Surveyed July 30 1957, by R.H. Whitby