


T.41 S.R.13 W.W.M.

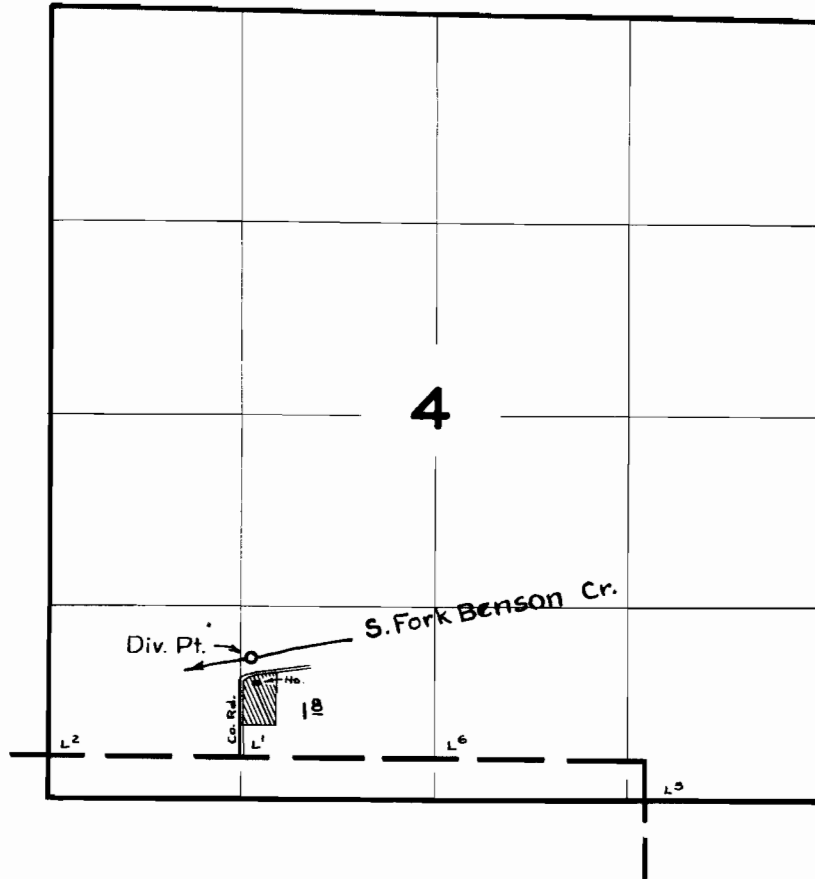

FINAL PROOF SURVEY UNDER

Application No. 28583 Permit No. 22523
IN NAME OF

Fred A. Anderson

Surveyed Mar 22 1958, by Tr. Bush