


T.4 S.R.4 W.W.M.

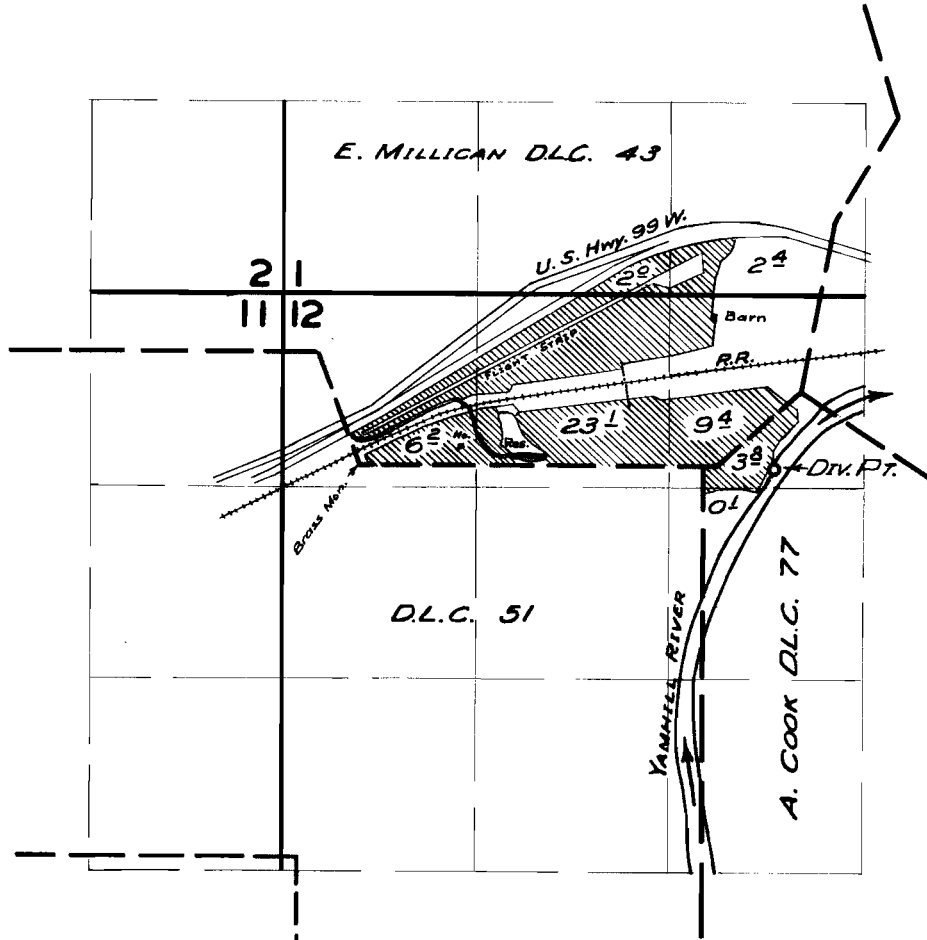

FINAL PROOF SURVEY UNDER

Application No. 28670 Permit No. 22577
IN NAME OF

JACK H. & HELEN C. WEEKS

Surveyed 8 May 1958, by M. Bish