


T.6S. R.3 W.W.M.

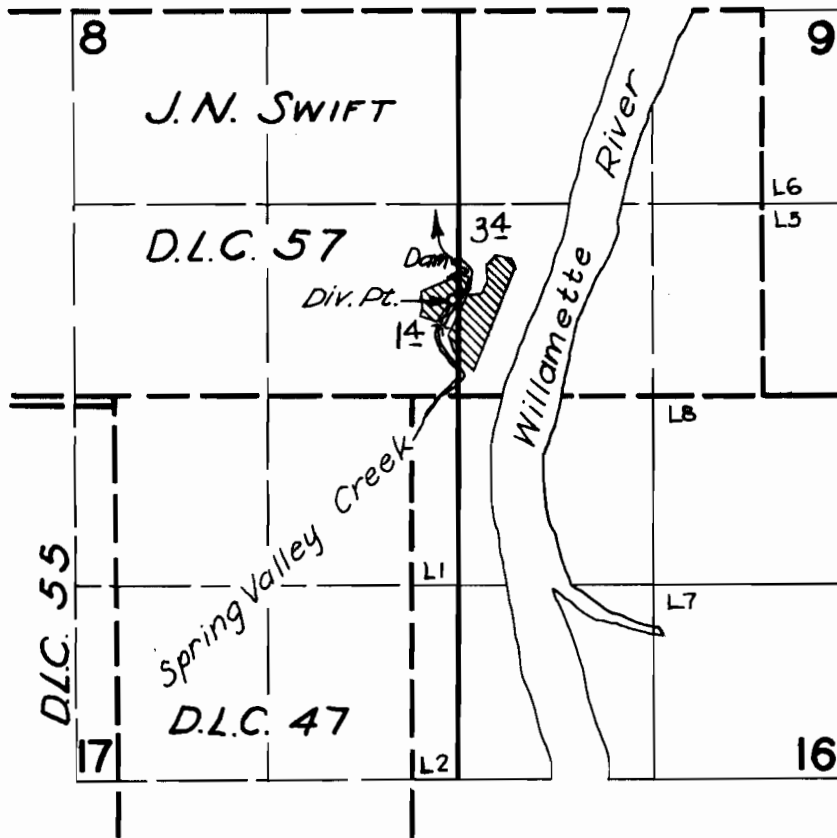

FINAL PROOF SURVEY
UNDER

Application No. 28674 Permit No. 22579
IN NAME OF

THEODORE DAUM

Surveyed April 10 1958, by R.H. Whitby.