


T.41 S.R.13 W.W.M.

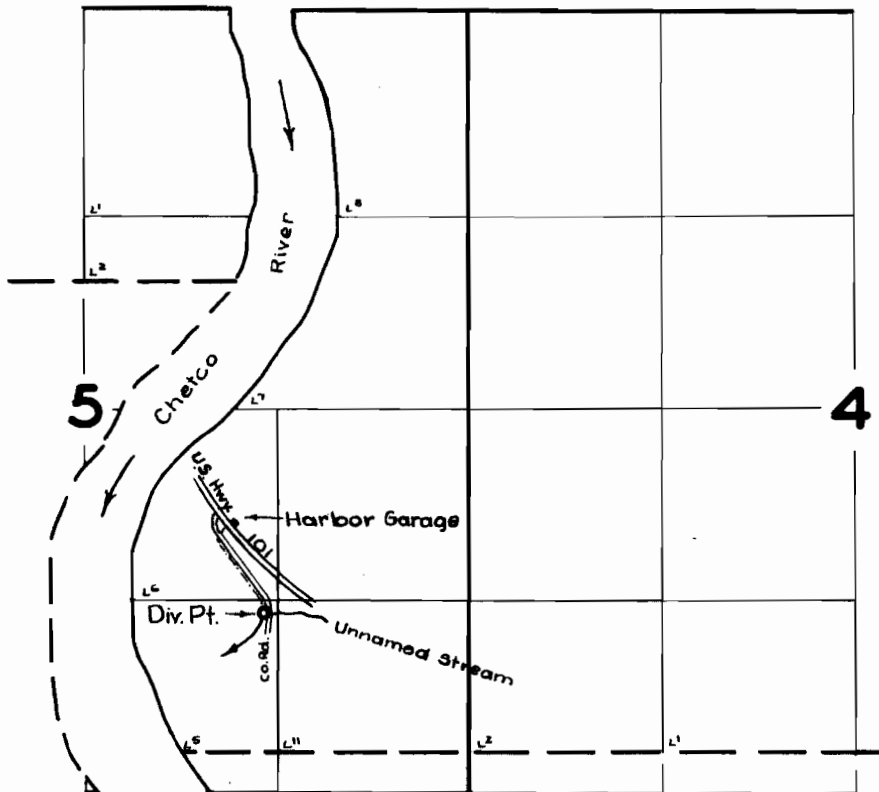

FINAL PROOF SURVEY
UNDER

Application No. 28760 Permit No. 22621

IN NAME OF

Russell D. Messer

Surveyed Mar. 18, 1958, by M. Bick