


T.40 S.R.14 W.W.M.

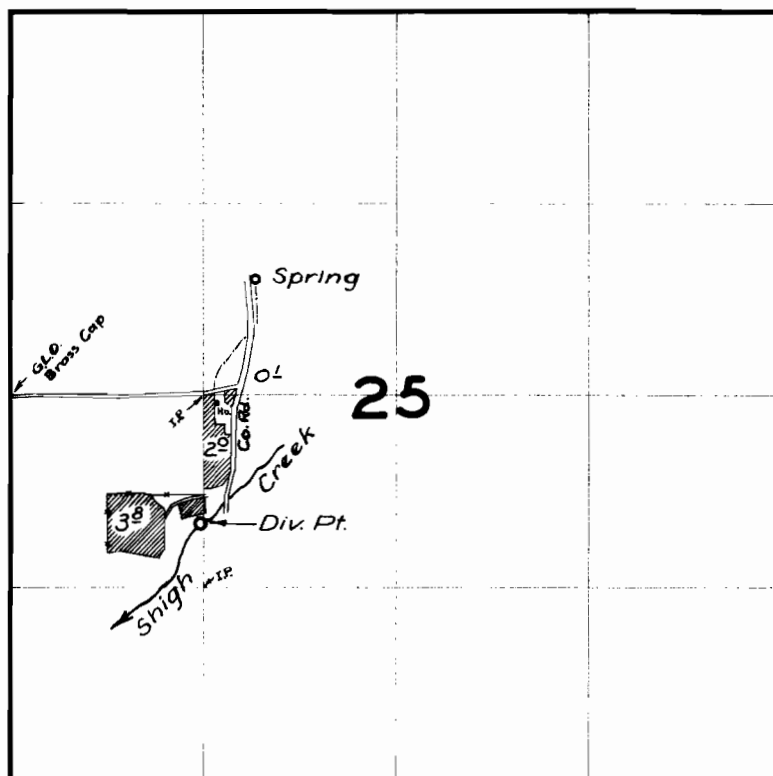

FINAL PROOF SURVEY UNDER

28805 22670
Application No. 30414 Permit No. 23893
IN NAME OF

D.C. & Virginia L. Longacre

Aug. 1 1961
Surveyed Mar. 24 1958, by M. Bish

1961-E
1958-B