


T.6 S.R.I.E.W.M.

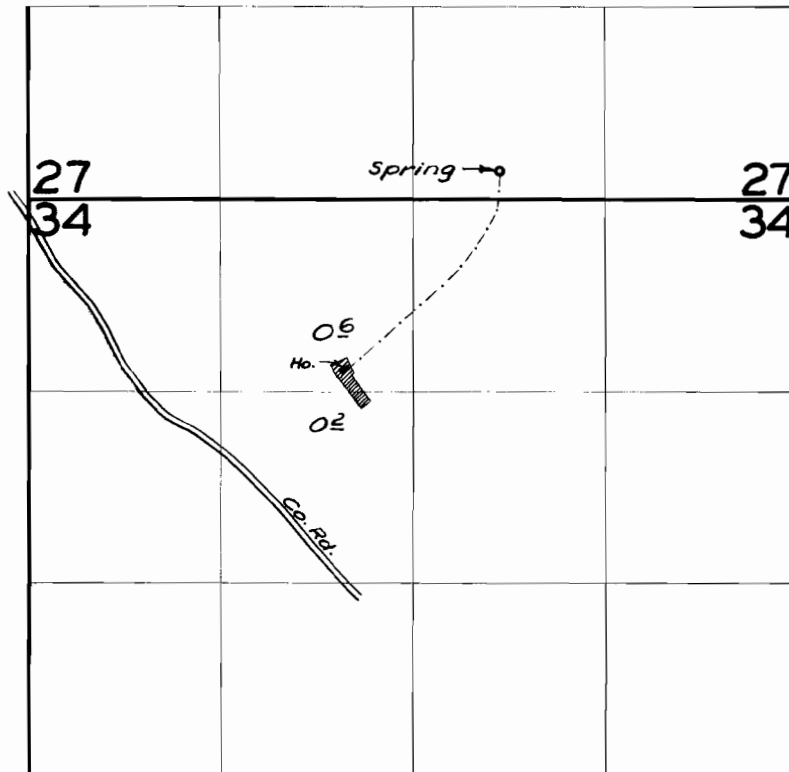

FINAL PROOF SURVEY UNDER

Application No. 28860 Permit No. 22698
IN NAME OF

Mrs. Lucy Dunagan

Surveyed 24 July 1958, by M. B. Sch