


T 6 S R 6 W W M

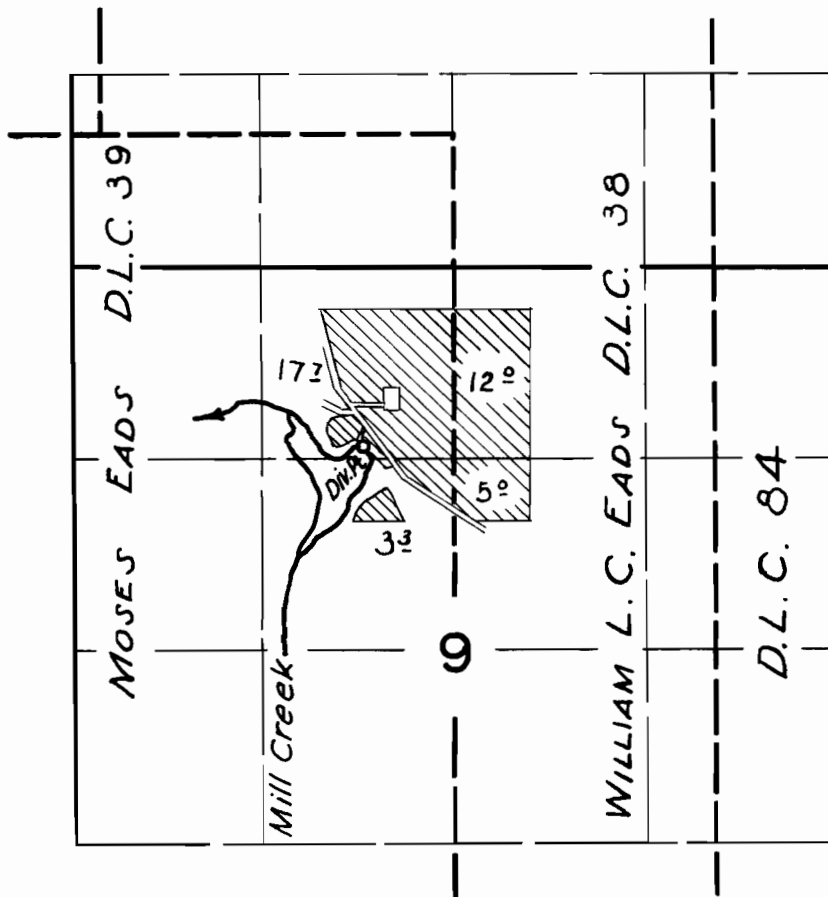

FINAL PROOF SURVEY
UNDER

Application No. 28971 Permit No. 22783
IN NAME OF

BERNARD JOSEPH RYAN

Surveyed April 8 1958, by R.H. Whitby