


T.8S. R.4W.W.M.

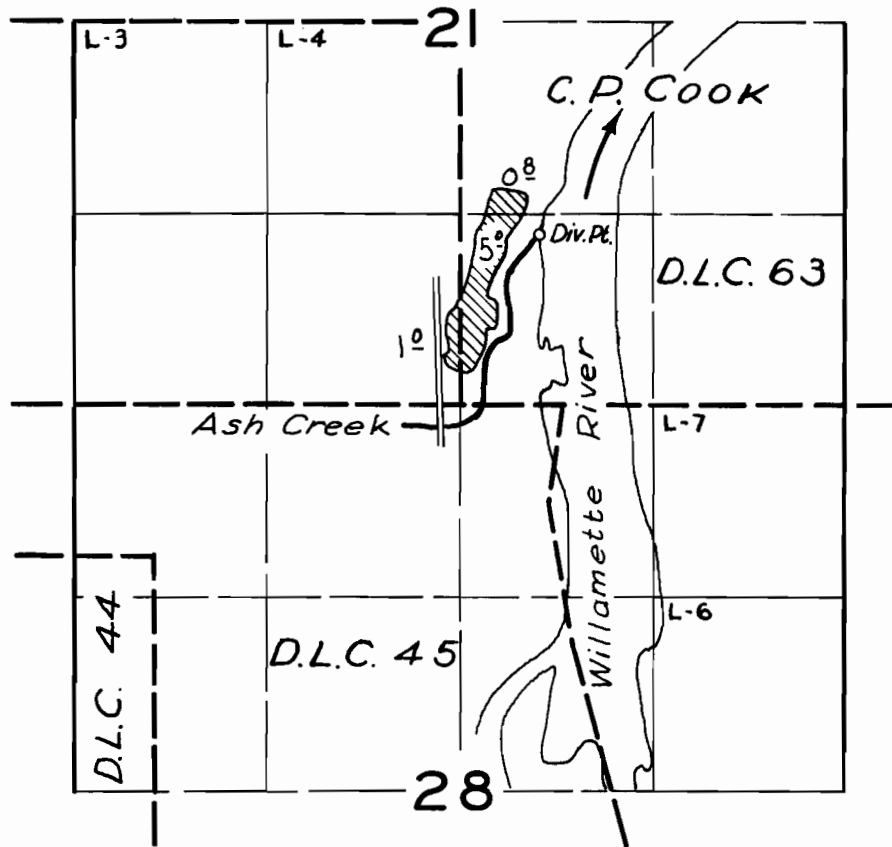

FINAL PROOF SURVEY
UNDER

Application No. 28349. Permit No. 22894
IN NAME OF

FRANCIS NEWTON

Surveyed April 22 1958, by R.H. Whitby