


T. 23 S. R. 32E. W.M.

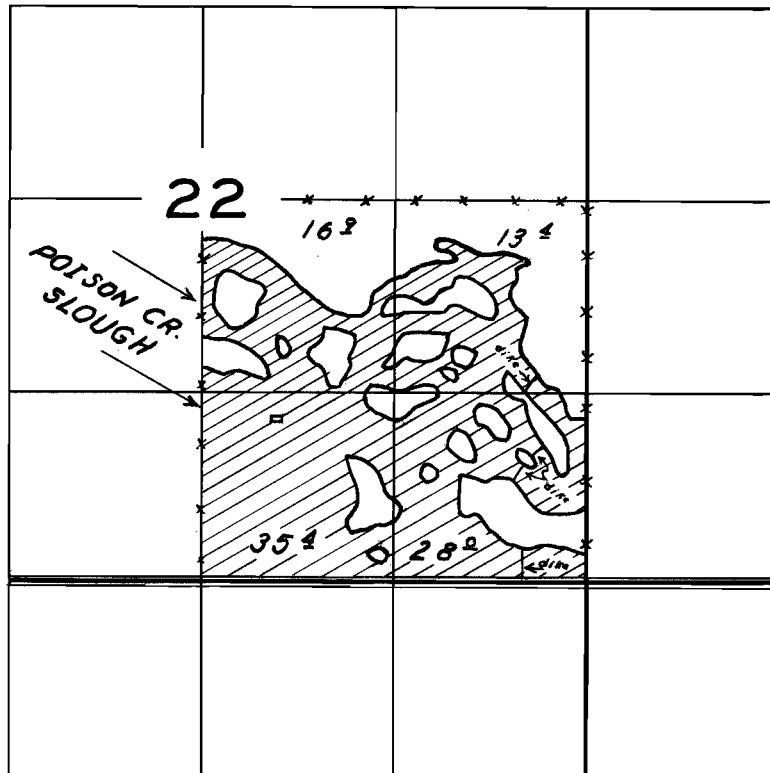

**FINAL PROOF SURVEY**  
UNDER

Application No. 29378 Permit No. 23100  
IN NAME OF

Treffle J. & Bessie Duhaime

Surveyed July 21 1958, by W.N. Perry