


I BERT W. UDELL OF LEBANON, OREGON DO HEREBY CERTIFY THAT THIS MAP WAS MADE FROM NOTES TAKEN DURING AN ACTUAL SURVEY MADE BY ME OR UNDER MY IMMEDIATE SUPERVISION ON DECEMBER 4, 1954; THAT THE MONUMENT SHOWN ON THIS MAP CONSISTING OF A 1 1/2" PIPE IS 831°E 1472' FROM THE NORTHWEST COR. OF SECTION 30 TOWNSHIP 14 SOUTH, RANGE 1 EAST W. M.

Bert W. Udell

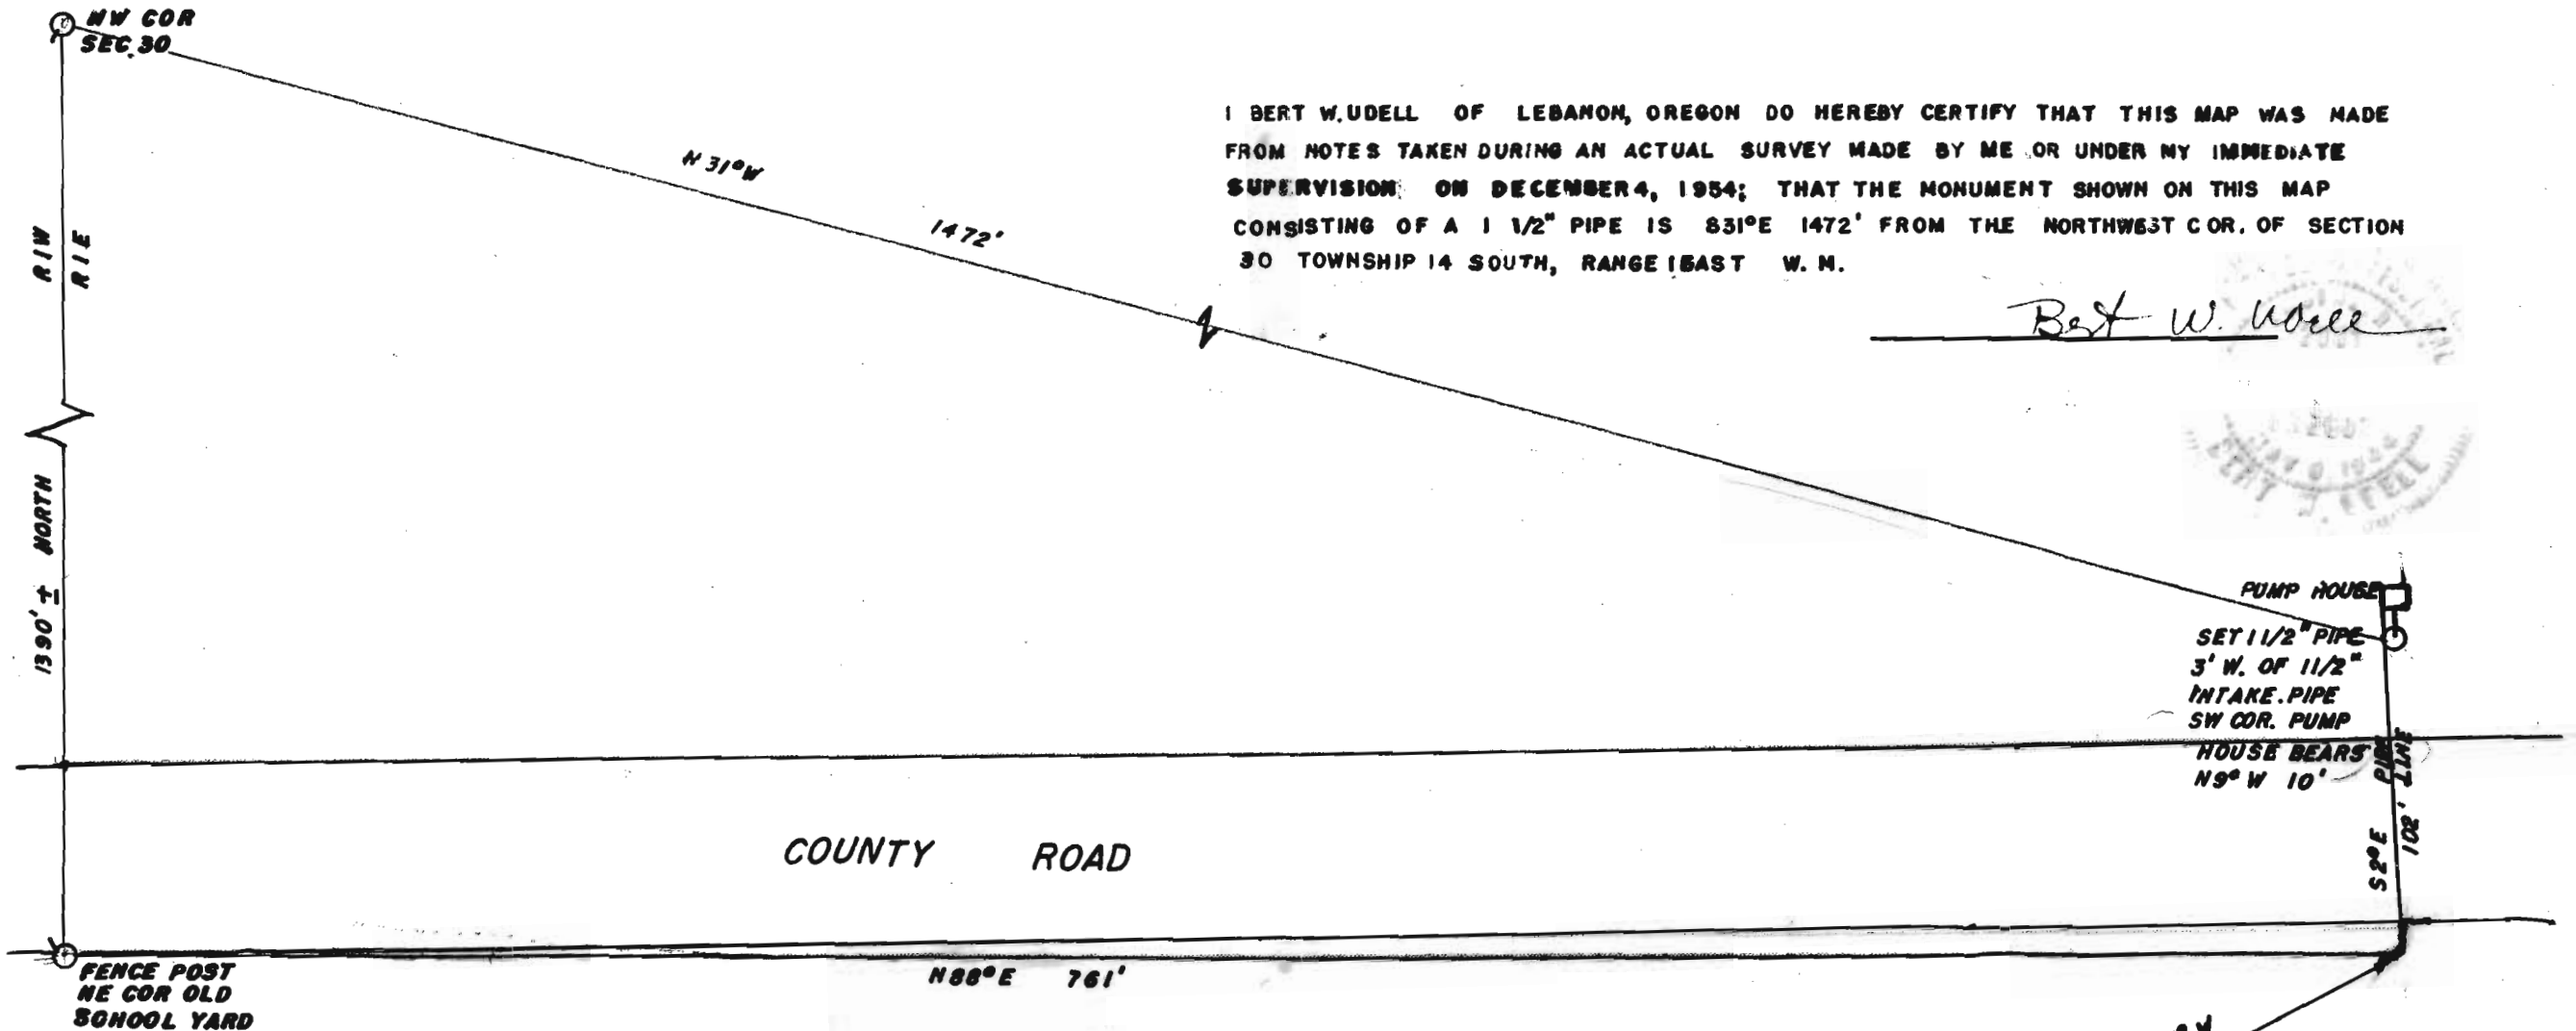

WATER RIGHT
FOR

MRS. L. H. JACOBSON
SEC 30 T14S R1E

SCALE 1" = 60'

RECEIVED
MAR 7 1955
STATE ENGINEER
SALEM, OREGON

QTR. HOUSE ADDN

Application No. 29127
Permit No. 23484