


T.41 S.R.13 W.W.M.

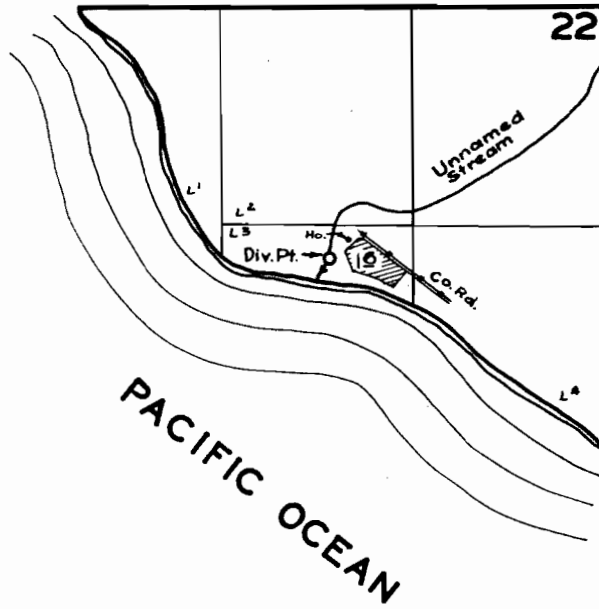

FINAL PROOF SURVEY
UNDER

Application No. 29832 Permit No. 23516
IN NAME OF

Walter W. & Eunice C. Wollam

Surveyed Mar. 21, 1958, by M. B. Bish