


T. 5S. R. 2E.W.M.

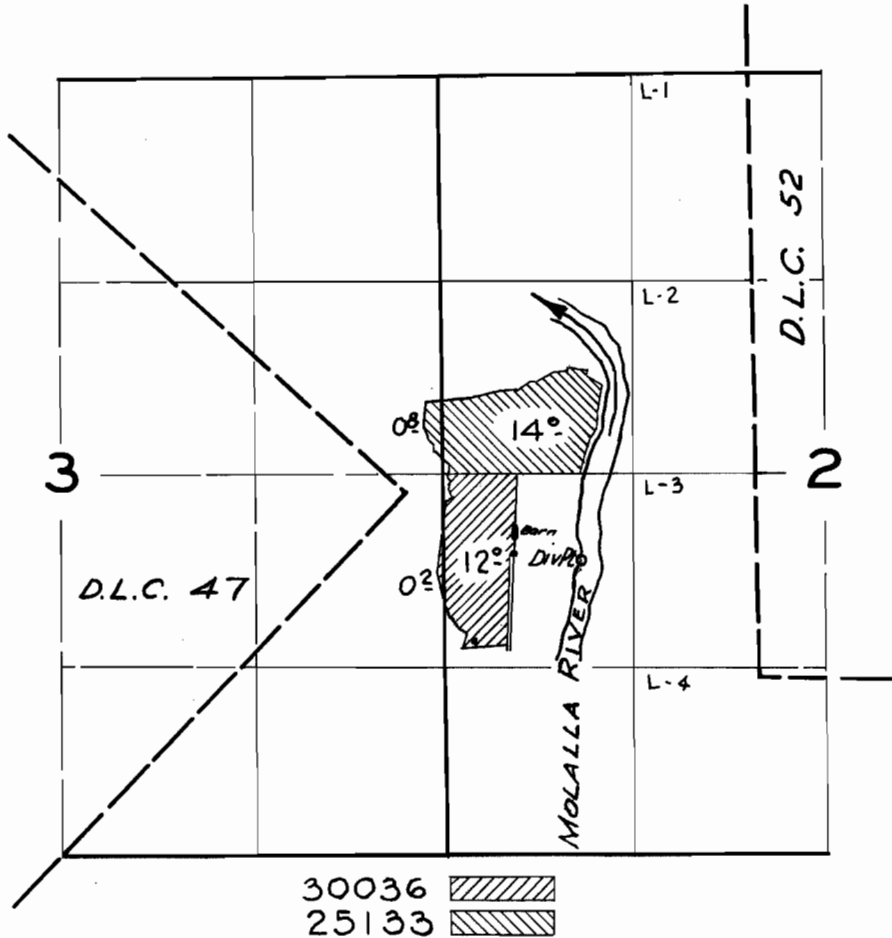

**FINAL PROOF SURVEY**  
UNDER

30036                      23645  
Application No. 25133. Permit No. 19775  
IN NAME OF

**GERALD WHITAKER**

Surveyed 17 June 1958, by C.O. Bartels