


APPLICATION NO. 29961
PERMIT NO. 23652

I, Frank Z. Howard, civil engineer, of Klamath Falls, Oregon, do hereby certify that this map was made from notes taken during an actual survey made under my direction on April 6, 1955, and from information taken from an aerial map, and that the section corner and meander corner were found as shown.

Frank J Howard

Frank 3 Howard

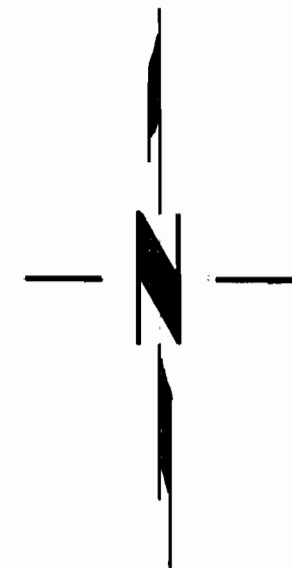

Pump and 36"
- discharge

Application No. 23652
Permit No. 23652

WATER RIGHT APPLICATION OF PAGE H. & MARJORIE N. LAMOREAUX		
PORTION OF SECTIONS 29, 30, 31 & 32, TWP. 36 S., R. 7 E., W.M.		
SURVEYED FOR	A.G. & M.N. LAMOREAUX	
SURVEYED BY	FRANK Z. HOWARD	4-6-55
DRAWN BY	F.Z.H.	4-19-55
SCALE	1" = 10 CHAINS	
APPROVED		