


T.5S. R.2E.W.M.

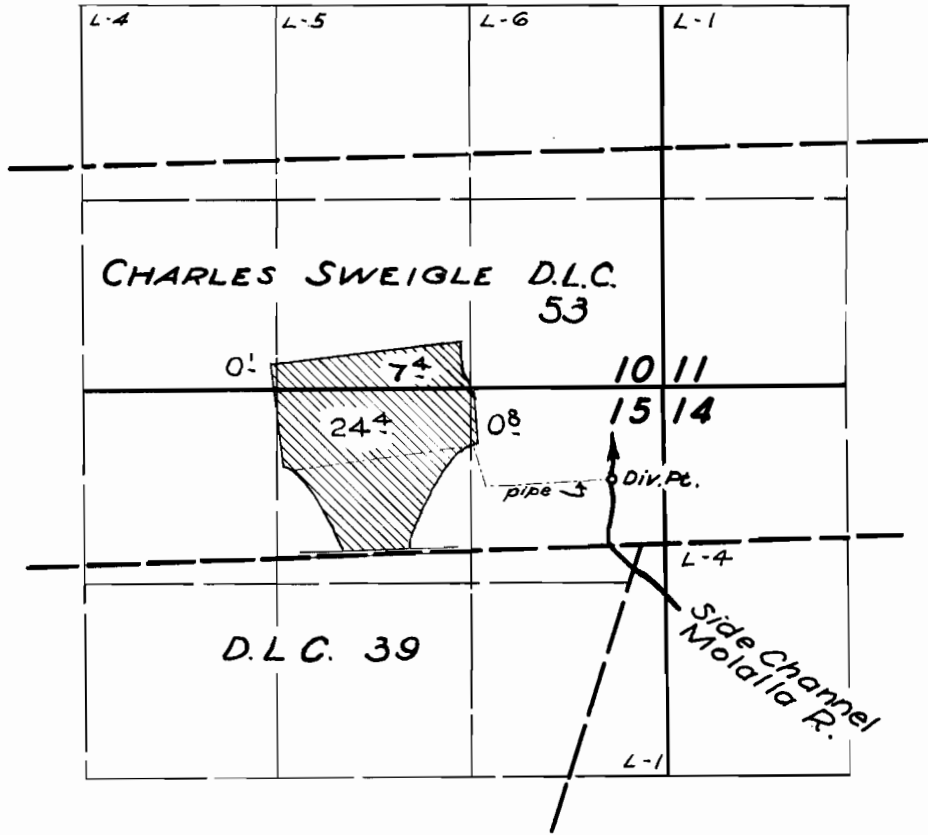

FINAL PROOF SURVEY
UNDER

Application No. 30196... Permit No. 23814...
IN NAME OF

CECIL C. SNYDER

Surveyed 19 June, 1958, by C.O. Bartels.