


T. IN. R. 3W. W.M.

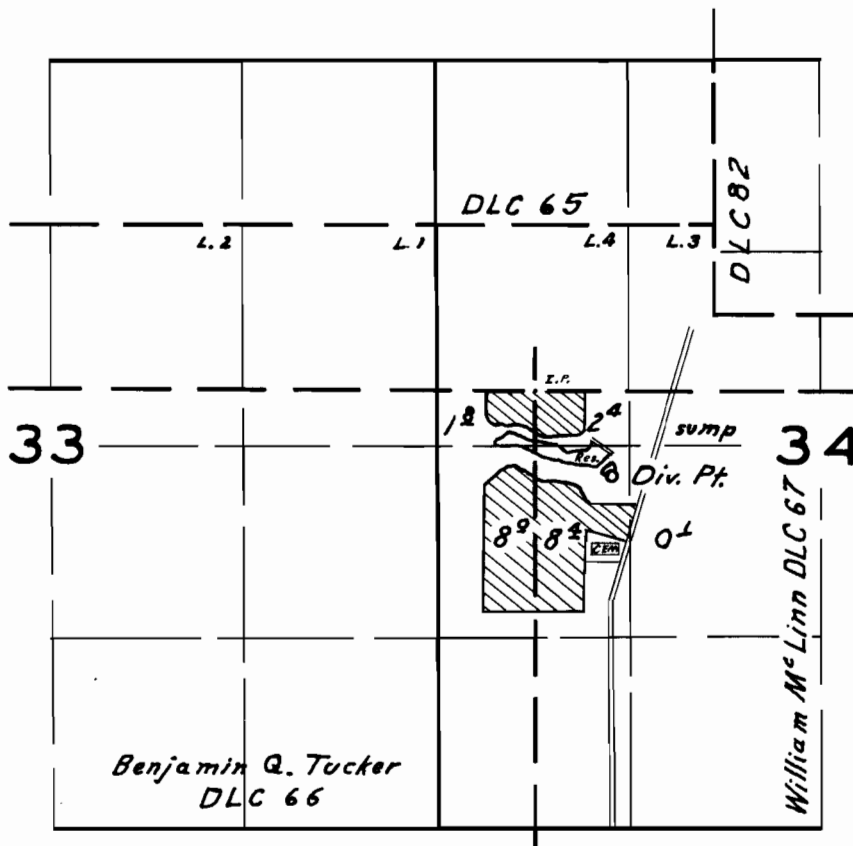

FINAL PROOF SURVEY
UNDER

Application No. 30745 Permit No. 24223
IN NAME OF

H. Leland Jacobsmuhlen

Surveyed April 30 1958, by *R. H. Whitby*