


T6S R6WWM

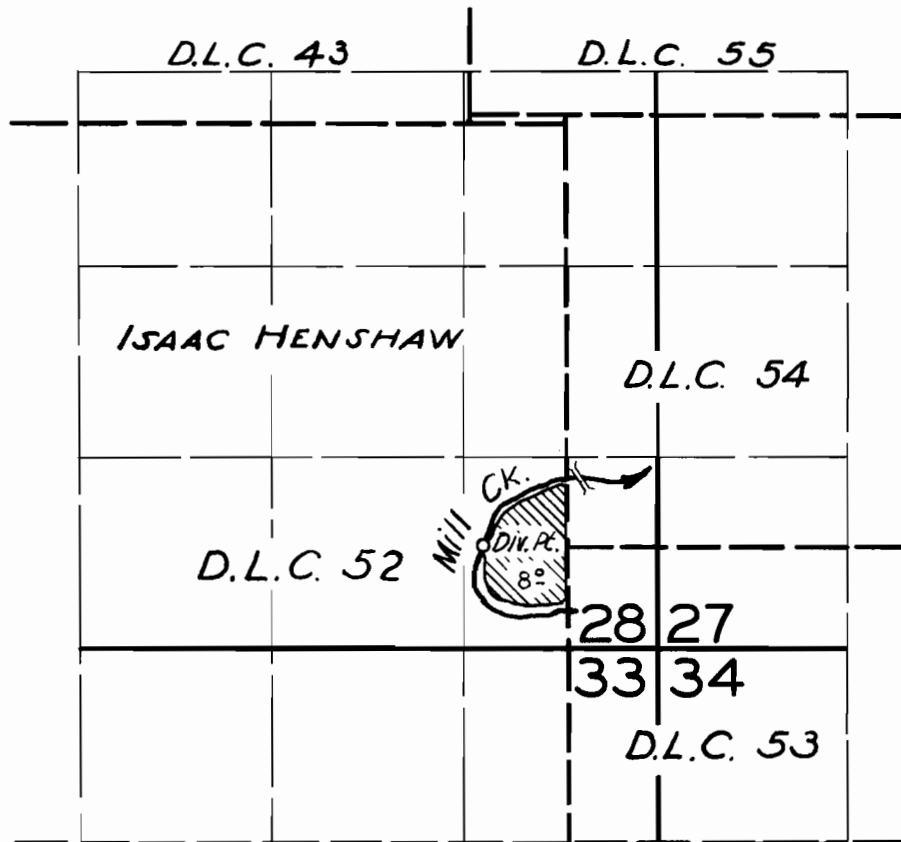

FINAL PROOF SURVEY UNDER

Application No. 30905 Permit No. 24333
IN NAME OF

DONNELL MITCHELL

Surveyed April 4 1958, by R.H. Whitby