


T. 36 S., R. 4 W., W.M.

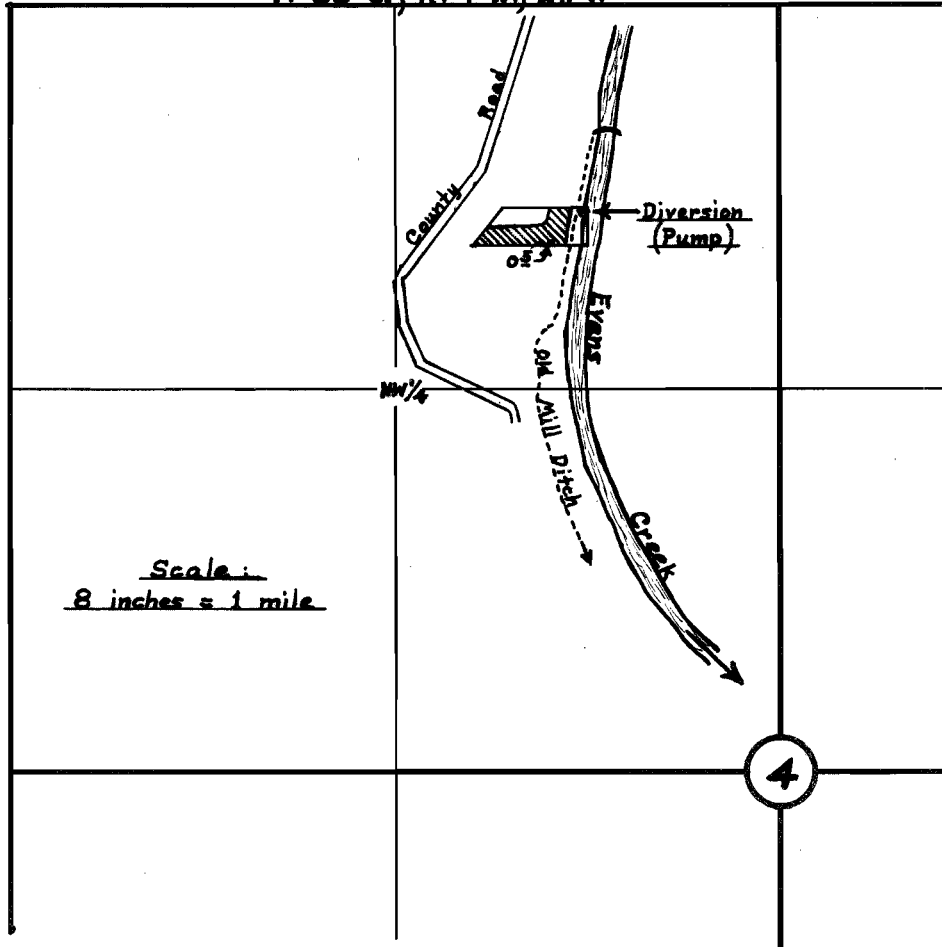

**FINAL PROOF SURVEY**  
UNDER

Application No. 30211 Permit No. 24334

IN NAME OF

Dudley Fabrick

Surveyed Dec. 5, 1958, by D.C. Hendrix, W.M.

REGISTERED  
SURVEYOR  
STATE ENGINEER  
W.V. SCHOOL