


T.6S. R.8 W.W.M.

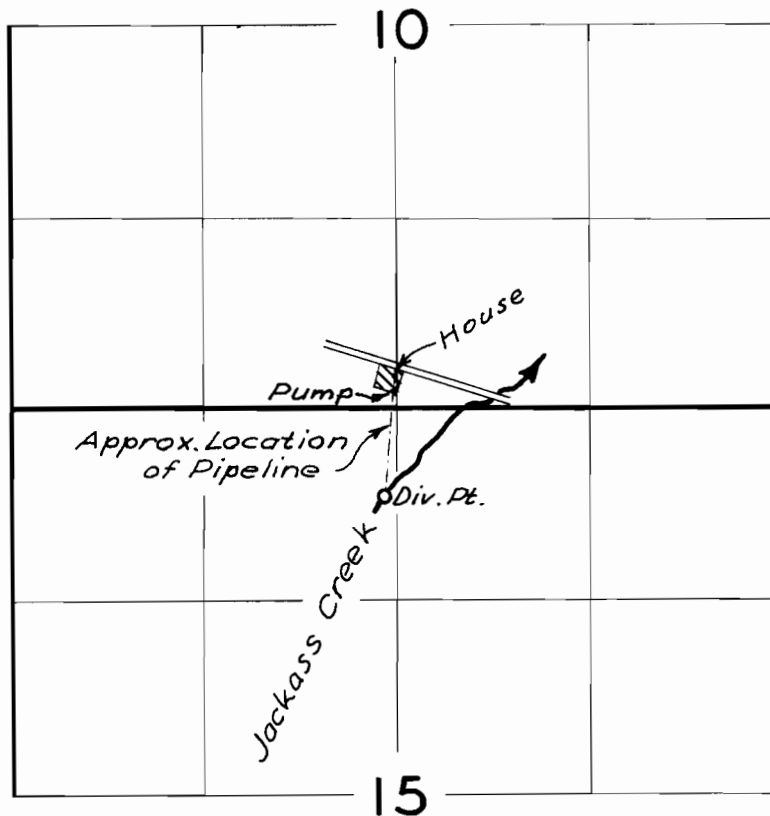

FINAL PROOF SURVEY
UNDER

Application No. 31008 . Permit No. 24451
IN NAME OF

JOHN H. TALBOTT

Surveyed April 10 1958, by R.H. Whitby