


# T.41 S.R.13 W.W.M.

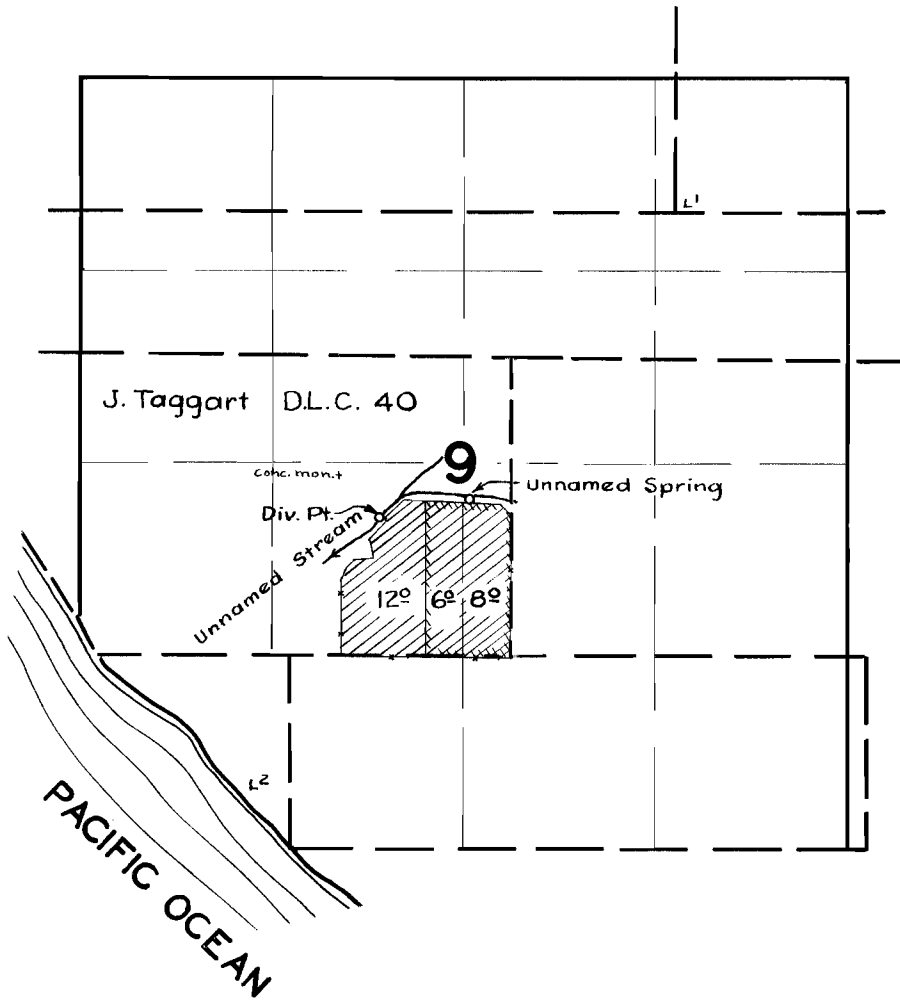

## FINAL PROOF SURVEY UNDER

Application No. 31502 Permit No. 24852  
IN NAME OF

Theodore Tamba

Surveyed Mar. 21 1958, by M. Bish