


T. 1 N. R. 3 W. W.M.

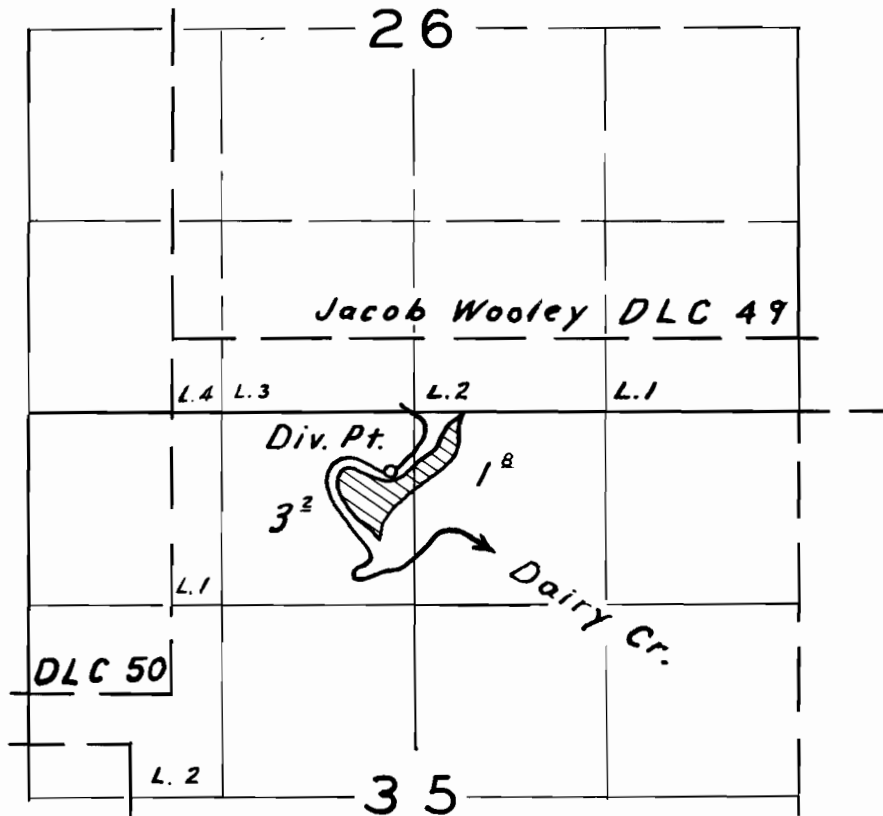

**FINAL PROOF SURVEY**  
UNDER

Application No. 31732 Permit No. 25014  
IN NAME OF

Clarence J. Waibel

Surveyed April 28 1958 by R. H. Whitby